THIS PERMIT VOIDS PREVIOUS ISSUED 8-29-98

IREDELL COUNTY HEALTH DEPARTMENT

STATESVILLE 704-878-5305 MOORESVILLE 704-664-5281

IMPROVEMENT PERMIT / AUTHORIZATION TO CONSTRUCT / OPERATION PERMIT / EXISTING SYSTEM INSPECTION

PERMIT# 075146 PIN# 4757 35 2459 (PT) DATE 1-11-02

OWNER OR CONTRACTOR DIXIELAND INC PHONE: Business 704-202-9971 Home

ADDRESS 4474 LAKE DR, SHERRILLS FORD NC 28673

LOCATION US 21 N TL BETHANY RD, TR GILEAD LANE, 6TH LOT ON RIGHT PAST BEREA LANE

SUBDIVISION BETHANY TRACE BLOCK / SECTION I LOT 18 LOT AREA 0.459 ACRE SITE CLASS PS DESIGN FLOW 360 L.T.A.R. 0.30 GPD/FT²

Septic Tank: 1000 Gallons: STB 825 Date 12-20-01

Pump Tank: Gallons: PT Date

Pump Make: Model Serial No

Nitrification Field: No Fields 1 Square Feet EQ.P 1200 Linear Feet 300

No Lines SIX Trench Width 36" Max Trench Bottom Depth 36" Gravel Depth N/A

☑ New System ☐ Repair System Type: I, II, (III), IV, V, VI

System Description: 25% REDUCTION, GRAVITY

Repair System Description: 50% REDUCTION LOW-PRESSURE

Maintenance Agreement Required: ☐ Yes ☒ No

☐ House/Mod Home No. Bedrooms 3

☐ Mobile Home No. Bathrooms 2

☐ Business No Employees

☐ Other


☐ Slab ☐ Crawl Space ☐ Basement w/plumbing ☐ Basement wo/plumbing

Water Supply: ☐ Individual ☑ Public ☐ Community


Comments/Conditions: ① INSTALL 25% REDUCTION SYSTEM USING THIRTY (30) HDS SECTIONS OR EQUIVALENT OR CHAMBERS USING CONTOUR WEAGES ② KEEP SYSTEM MINIMUM TEN FEET FROM WATER LINE

Comments/Conditions: ① SEPTIC TANK W/ MARKER INSTALLED USING "POLYLOK" FILTER ② SYSTEM COVERED DURING RAINY WEATHER

INITIAL SITE SKETCH

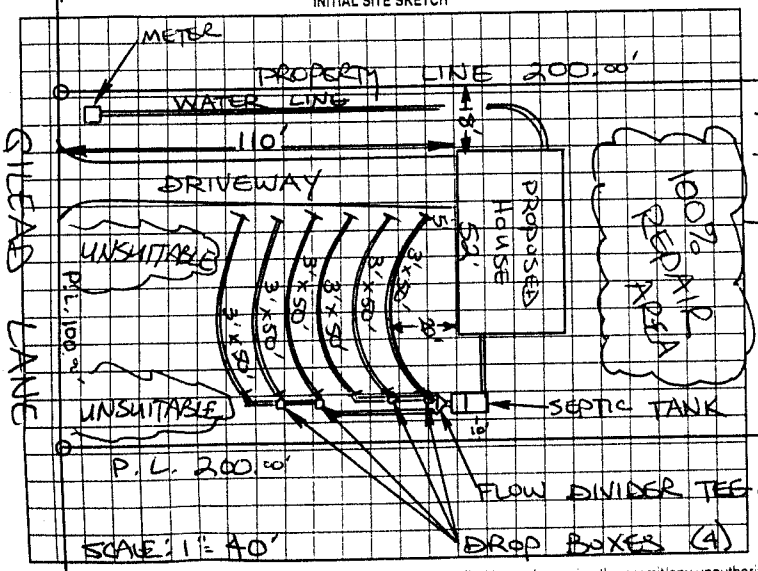

AS BUILT SKETCH

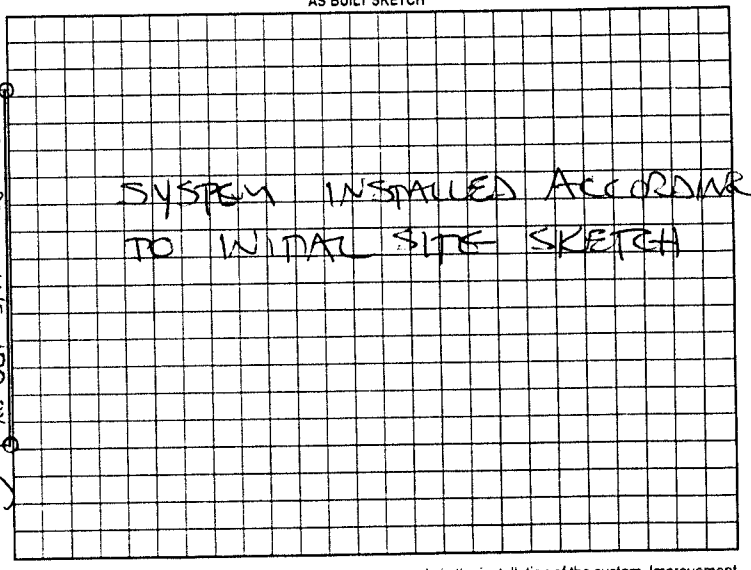

Permit can be suspended or revoked if any false information is supplied toward securing the permit/any unauthorized changes are made to the site/any unauthorized changes are made in the installation of the system. Improvement Permit with plat valid without expiration. Improvement Permit with site plan valid for sixty months. Authorization to Construct is valid for a period equal to that of Improvement Permit – not to exceed sixty months.

~~Signed~~: Signed X Cecil date 1/14/02

Improvement Permit by: STEVE HEDRICK date 1-11-02

Authorization to Construct by: STEVE HEDRICK date 1-11-02

Installed by: ROWAN SEPTIC TANK

Operation Permit by: STEVE HEDRICK date 2-20-02

Existing System Inspection by: date

HEALTH DEPT COPY WHITE OWNER COPY (FINAL) YELLOW OWNER COPY (INITIAL) PINK