Peter Odonnell

202386

IREDELL COUNTY HEALTH DEPARTMENT

STATESVILLE 704-878-5305 MOORESVILLE 704-664-5281

IMPROVEMENT PERMIT / AUTHORIZATION TO CONSTRUCT / OPERATION PERMIT / EXISTING SYSTEM INSPECTION

PERMIT# 75141 PIN# 4757 35 2459 DATE 4-18-01

OWNER OR CONTRACTOR DIXIELAND INC. PHONE: Business 828-478-5331 Home

ADDRESS 4474 LAKE DR. SHERRILLS FORD, N.C. 28673

LOCATION US 21 N, ⓛ BETHANY RD ⓡ GILEAD LN, 11TH LOT ON RT

SUBDIVISION BETHANY TRACE BLOCK / SECTION LOT 16 LOT AREA 1.53 SITE CLASS. PS DESIGN FLOW 320 L.T.A.R. .5

Septic Tank: 1000 Gallons: STB B25 Date 3-5-01 ☒ New System ☐ Repair System Type: I, II, (III), IV, V, VI

Pump Tank: Gallons, PT Date System Description: GRAV. 25% RED

Pump Make: Model Serial No. Repair System Description: PUMP CP PANEL

Nitrification Field: No Fields 1 Square Feet EA=1200 Lineal Feet 300' Maintenance Agreement Required: ☐ Yes ☐ No

No Lines 5 Trench Width 36" Max. Trench Bottom Depth 36" Gravel Depth N/A ☐ Slab ☒ Crawl Space ☐ Basement w/plumbing ☐ Basement wo/plumbing

☒ House/Mod. Home No. Bedrooms 3

☐ Mobile Home No. Bathrooms 2

☐ Business No. Employees


☐ Other

Water Supply: ☐ Individual ☒ Public ☐ Community


Comments/Conditions:

Comments/Conditions: ① Keep system 5' off house, 10' off property line & 15' off top of EMBANKMENT ② KEEP HOUSE 10' FROM SYSTEM ③ INSTALL LINES ON CONTOUR

INITIAL SITE SKETCH

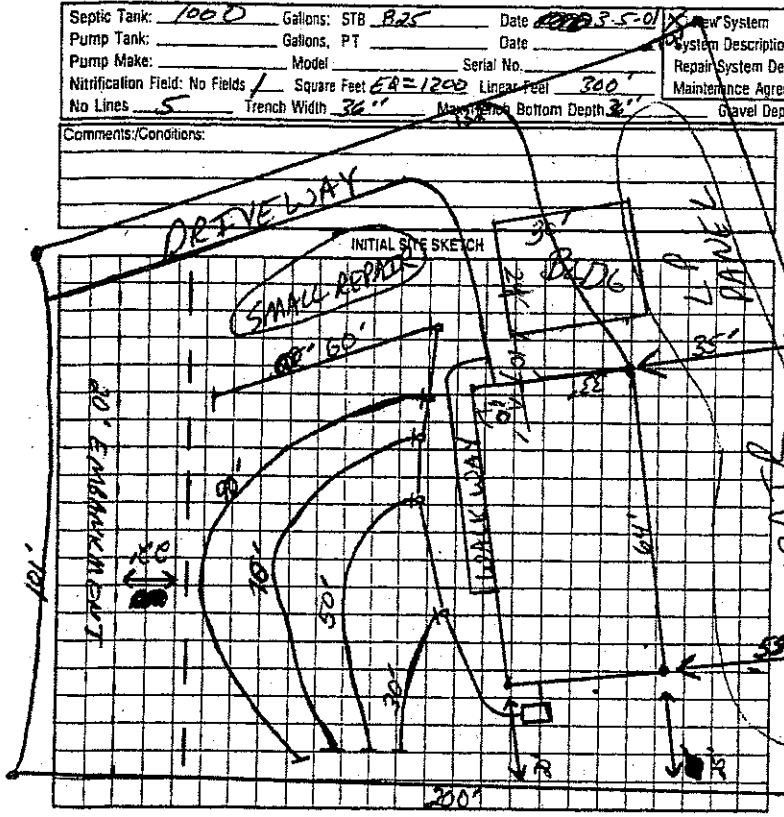

AS BUILT SKETCH

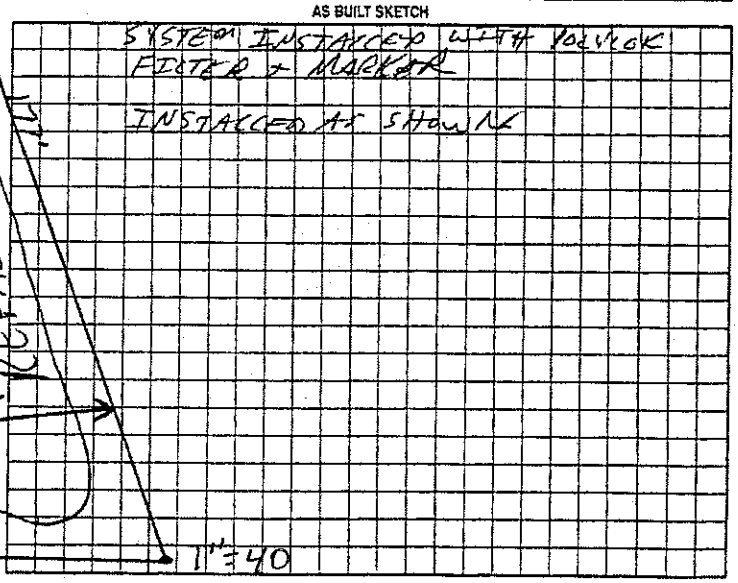

Permit can be suspended or revoked if any false information is supplied toward securing the permit/any unauthorized changes are made to the site/any unauthorized changes are made in the installation of the system. Improvement Permit with plat valid without expiration. Improvement Permit with site plan valid for sixty months. Authorization to Construct is valid for a period equal to that of Improvement Permit – not to exceed sixty months.

Signed: [signature] date 4/23/01 Installed by: ROWAN SEPTIC

Improvement Permit by: [signature] RST date 4-18-01 Operation Permit by: [signature] RST date 5-4-01

Authorization to Construct by: [signature] RST date 4-18-01 Existing System Inspection by: date

HEALTH DEPT. COPY. WHITE OWNER COPY (FINAL). YELLOW OWNER COPY (INITIAL) PINK

Location of the proposed 24'x30' BLDG addition does not appear to impact the existing on-site septic system or well.NOTE:**

[signature] REHS Date: 04/07/14

ICHD-Environmental Health Division