IREDELL COUNTY HEALTH DEPARTMENT

STATESVILLE 704-878-5305 MOORESVILLE 704-664-5281

IMPROVEMENT PERMIT / AUTHORIZATION TO CONSTRUCT / OPERATION PERMIT / EXISTING SYSTEM INSPECTION

PERMIT# 82029 PIN# 4757352459 DATE 6-29-99

OWNER OR CONTRACTOR Spear Const. PHONE: Business 664-4445 Home

ADDRESS 607 Anderson Rd Salisbury N.C.

LOCATION 21 N TL Bethany TR Gilead TR Berea TL Mt Zion 1st lot left.

SUBDIVISION Bethany Trace BLOCK / SECTION 2 LOT 31 LOT AREA .45 acres SITE CLASS PS DESIGN FLOW 360 L.T.A.R. .13

Septic Tank: 1000 Gallons; STB 825 Date 5-1-01
Pump Tank: Gallons; PT Date
Pump Make: Model Serial No.
Nitrification Field: No Fields 1 Square Feet 900 Linear Feet 300
No Lines 5 Trench Width 36" Max Trench Bottom Depth 36" Gravel Depth N/A

☑ New System ☐ Repair System Type: I. II. III. IV. V. VI
System Description: Gravity 25% Reduction
Repair System Description: Pump To 25% Reduction
Maintenance Agreement Required ☐ Yes ☑ No

☑ House/Mod. Home No. Bedrooms 3
☐ Mobile Home No. Bathrooms 2
☐ Business No. Employees
☐ Other
☐ Slab ☑ Crawl Space ☐ Basement w/plumbing ☐ Basement wo/plumbing


Water Supply: ☐ Individual ☑ Public ☐ Community

Comments/Conditions:


NO SITE SKETCH OL APPLICATION OR SOIL SHEET ATTACHED LO 6-28-01

Comments/Conditions: SYSTEM INSTALLED ON CONTOUR ENDING LINES 18' OFF CENTER OF DITCH TO UPHOLD SYSTEM DESIGNED 6-29-99. 10' OFF TOP OF DITCH 6-28-01 INSTALLED AS SHOWN BELOW. WITH DULY LOG FIGURE

INITIAL SITE SKETCH

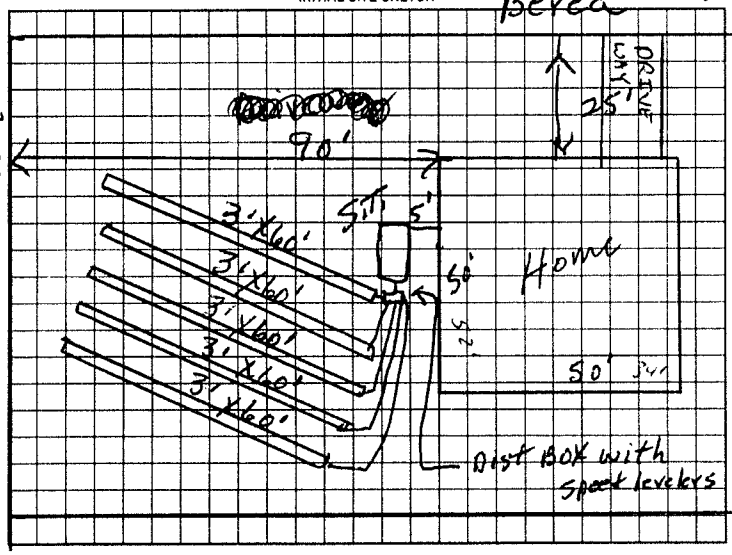

AS BUILT SKETCH

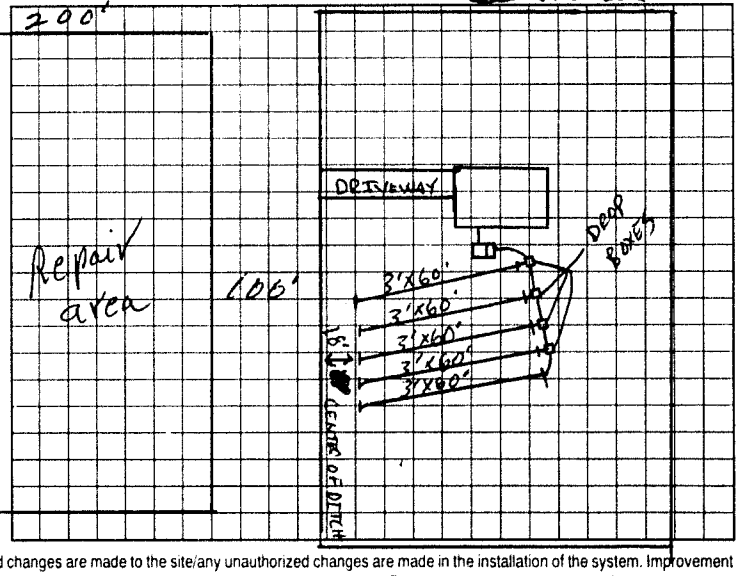

Permit can be suspended or revoked if any false information is supplied toward securing the permit/any unauthorized changes are made to the site/any unauthorized changes are made in the installation of the system. Improvement Permit with plat valid without expiration. Improvement Permit with site plan valid for sixty months. Authorization to Construct is valid for a period equal to that of Improvement Permit – not to exceed sixty months.

Signed: Regina Cecil date 1/9/2001 Installed by: ROWAN SEPTIC

Improvement Permit by: F.C. Moore date 6-29-99 Operation Permit by: [signature] EST date 6-28-01

Authorization to Construct by: F.C. Moore date 6-29-99 Existing System Inspection by: date

HEALTH DEPT. COPY: WHITE OWNER COPY (FINAL) YELLOW OWNER COPY (INITIAL) PINK