THIS PERMIT REPLACES ONE PREVIOUSLY ISSUED ON 6-29-99

IREDELL COUNTY HEALTH DEPARTMENT

STATESVILLE 704-878-5305 MOORESVILLE 704-664-5281

IMPROVEMENT PERMIT / AUTHORIZATION TO CONSTRUCT / OPERATION PERMIT / EXISTING SYSTEM INSPECTION

PERMIT# 82033 PIN# 4757352459 DATE 5-29-01

OWNER OR CONTRACTOR SPEAR CONST PHONE: Business 664-4445 Home

ADDRESS 607 ANDERSON RD, SALISBURY, N.C.

LOCATION 21N, (L) BETHANY RD, (R) GILEAD (R) BEREA, (L) MT ZION 4th on Left

SUBDIVISION BETHANY TRACE BLOCK / SECTION LOT 34 LOT AREA .45 SITE CLASS PS DESIGN FLOW 360 L.T.A.R. .3

Septic Tank: 1000 Gallons; STB 825 Date 3-1-01

Pump Tank: Gallons; PT Date

Pump Make: Model Serial No.

Nitrification Field: No Fields 1 Square Feet EQ=1200 Linear Feet 300'

No Lines 5 Trench Width 36" Max Trench Bottom Depth 36" Gravel Depth N/A

X New System ☐ Repair System Type: I, II, (III), IV, V, VI

System Description: CONV 25% RED

Repair System Description: PUMP CONV

Maintenance Agreement Required: ☐ Yes X No

☐ Slab X Crawl Space ☐ Basement w/plumbing ☐ Basement wo/plumbing

X House/Mod. Home ☐ Mobile Home ☐ Business ☐ Other


No. Bedrooms 3 No. Bathrooms 2 No. Employees

Water Supply: ☐ Individual X Public ☐ Community

Comments:/Conditions: (1) MAINTAIN SETBACKS (2) GRADE FRONT OF LOT TO WHERE CONTOURS ARE AS SHOWN BELOW, Will not require much grading.

Comments:/Conditions: POLYLOK FILTER & MARKER INSTALLED AS SHOWN

INITIAL SITE SKETCH

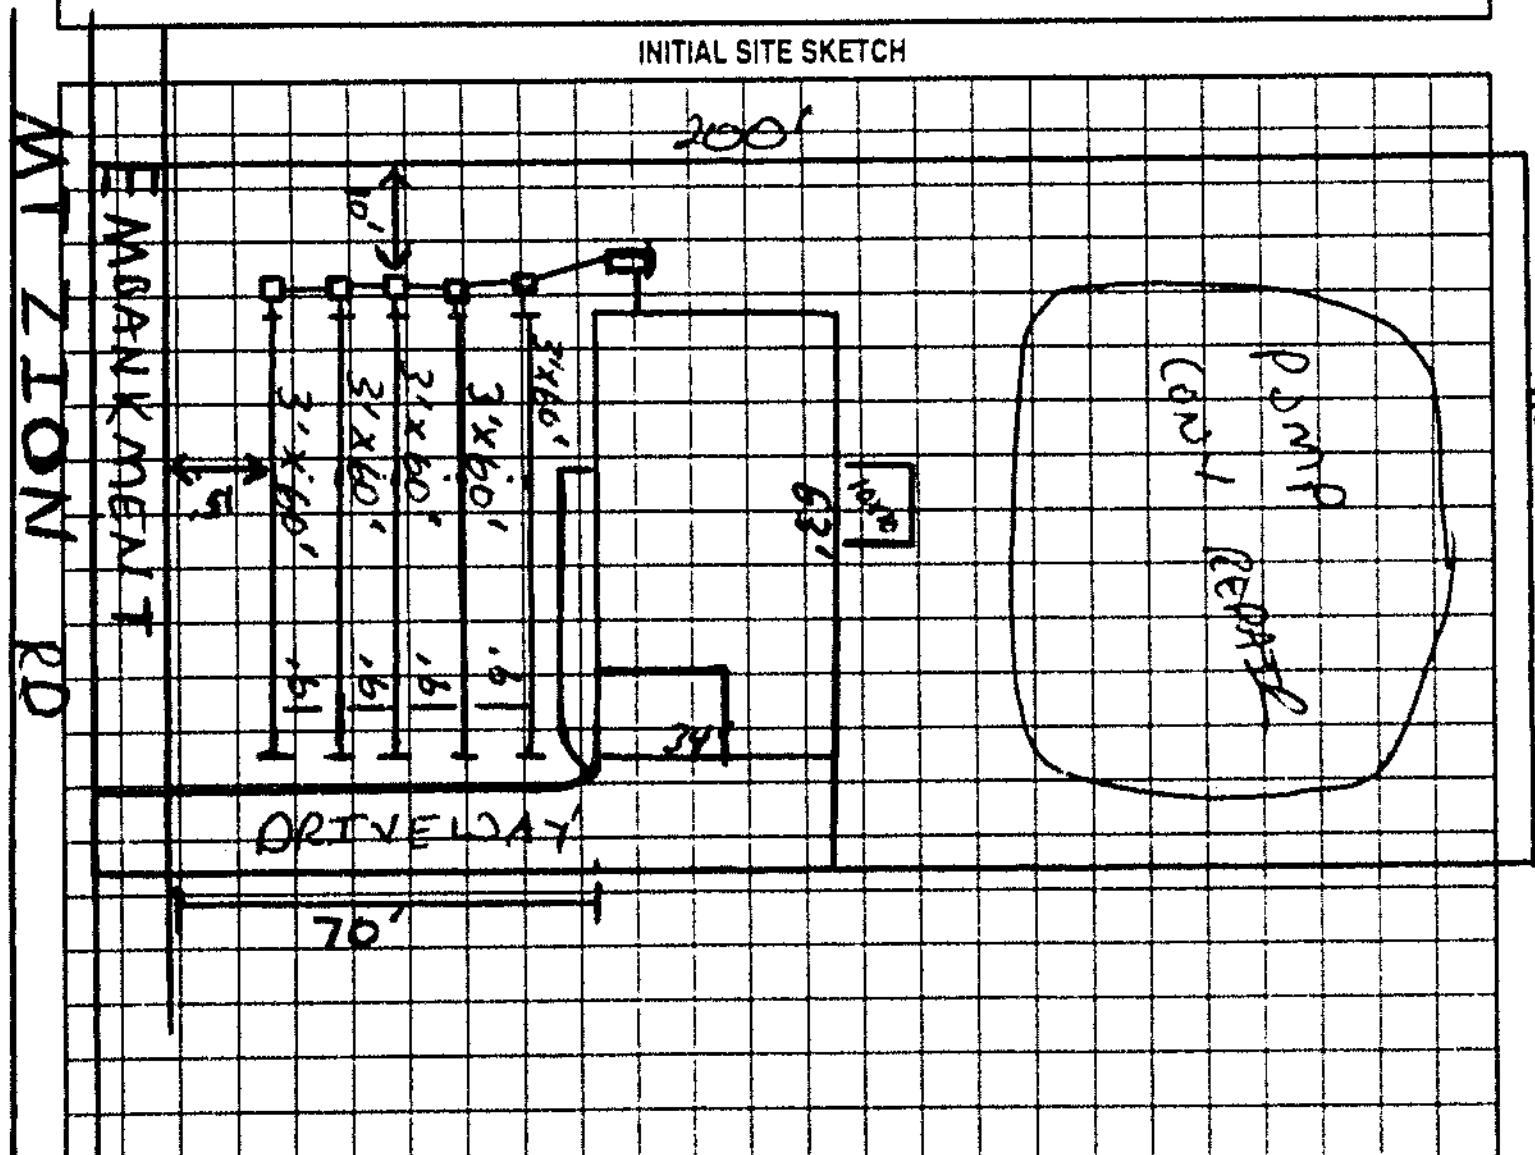

AS BUILT SKETCH

Permit can be suspended or revoked if any false information is supplied toward securing the permit/any unauthorized changes are made to the site/any unauthorized changes are made in the installation of the system. Improvement Permit with plat valid without expiration. Improvement Permit with site plan valid for sixty months. Authorization to Construct is valid for a period equal to that of Improvement Permit – not to exceed sixty months.

Signed: [signature] date 6/1/01 Installed by: ROWAN SEPTIC

Improvement Permit by: [signature] RSI date 5-29-01 Operation Permit by: [signature] RS date 7-31-01

Authorization to Construct by: [signature] RSI date 5-29-01 Existing System Inspection by: date

HEALTH DEPT COPY WHITE OWNER COPY (FINAL) YELLOW OWNER COPY (INITIAL) PINK