IREDELL COUNTY HEALTH DEPARTMENT

STATESVILLE 704-878-5305 — MOORESVILLE 704-664-5281

IMPROVEMENT PERMIT / AUTHORIZATION TO CONSTRUCT / OPERATION PERMIT / EXISTING SYSTEM INSPECTION

PERMIT# 089937 PIN# 4757352459 (pt.) DATE March 29, 01

OWNER OR CONTRACTOR Dixieland Inc PHONE: Business (704) 202-4971 Home

ADDRESS 4474 Lake Dr. Sherrills Ford NC 28673

LOCATION From St 801 21 N. TL Bethany Rd TR Gilead TR Berea TL Mt Zion on left

SUBDIVISION Bethany Trace BLOCK / SECTION 1 LOT 37 LOT AREA .7293 Ac SITE CLASS PS DESIGN FLOW 360 gpd L.T.A.R. .3

Septic Tank: 1000 Gallons; STB 825 Date 4-3-01
Pump Tank: Gallons; PT Date
Pump Make: Model Serial No.
Nitrification Field: No Fields 1 Square Feet 1200 Linear Feet 400
No Lines 5 @ 80' Trench Width 36" Max Trench Bottom Depth 36" Gravel Depth 12"

☒ New System ☐ Repair System Type: I (II) III, IV, V, VI
System Description: Gravity Conventional
Repair System Description: Gravity/pumped conventional
Maintenance Agreement Required: ☐ Yes ☒ No

☒ House/Mod. Home No. Bedrooms 3
☐ Mobile Home No. Bathrooms 2
☐ Business No. Employees
☐ Other
☐ Slab ☒ Crawl Space ☐ Basement w/plumbing ☐ Basement wo/plumbing


Water Supply: ☐ Individual ☒ Public ☐ Community

Comments/Conditions: Do not cut or lower house site. Rear of house to be 110' off front R/W.
4-2-01 Reviewed house plan - locate front of house 69' off front (street) R/W.


Comments/Conditions: SYSTEM INSTALLED AS SHOWN WITH POLYLOK FILTER & MARKER

1"=50'

INITIAL SITE SKETCH

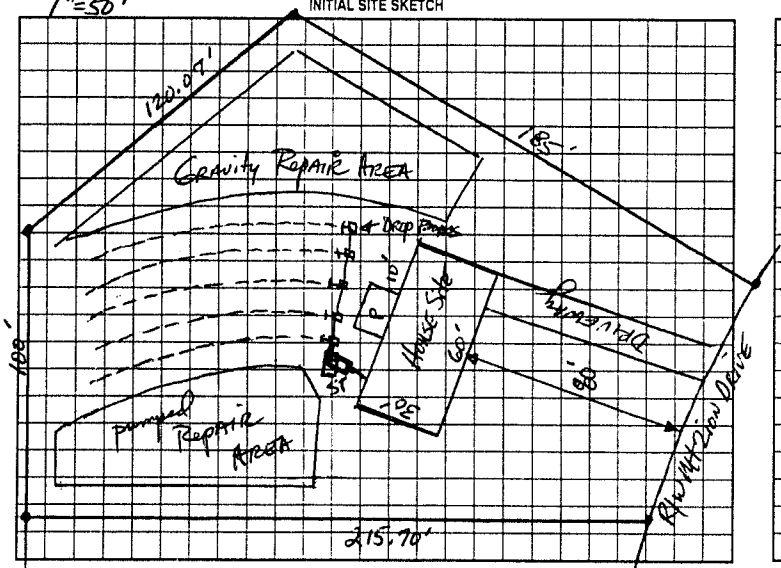

AS BUILT SKETCH

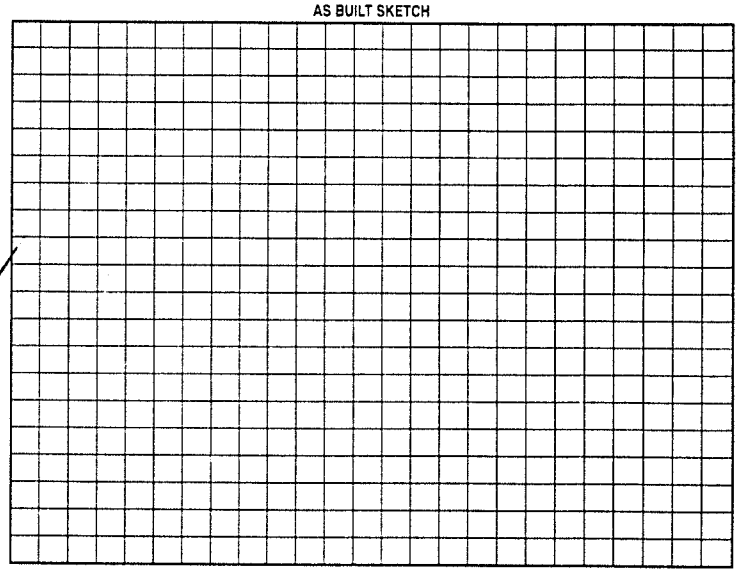

Permit can be suspended or revoked if any false information is supplied toward securing the permit/any unauthorized changes are made to the site/any unauthorized changes are made in the installation of the system. Improvement Permit with plat valid without expiration. Improvement Permit with site plan valid for sixty months. Authorization to Construct is valid for a period equal to that of Improvement Permit – not to exceed sixty months.

Signed: Glenn Cecil date 4/2/01
Improvement Permit by: [signature], RS date 3-29-01
Authorization to Construct by: [signature], RS date 4-2-01

Installed by: ROWAN SEPTIC
Operation Permit by: [signature] RS+ date 6-4-01
Existing System Inspection by: date

HEALTH DEPT. COPY: WHITE OWNER COPY (FINAL): YELLOW OWNER COPY (INITIAL): PINK