# IREDELL COUNTY HEALTH DEPARTMENT

STATESVILLE 704-878-5305 MOORESVILLE 704-664-5281

## IMPROVEMENT PERMIT / AUTHORIZATION TO CONSTRUCT / OPERATION PERMIT / EXISTING SYSTEM INSPECTION

PERMIT# 088568 PIN# 4757 35 2459 (PART) DATE 4-15-00

OWNER OR CONTRACTOR DIXIE LAND INC. PHONE: Business (828) 478-5331 Home

ADDRESS 4479 LAKE DRIVE, SHERRILLS FORD, NC 28673

LOCATION US 21 N, TL BETHANY RD, TR BEREA LANE, TL MT. ZION DRIVE, 7TH LOT ON RIGHT

SUBDIVISION BETHANY TRACE BLOCK / SECTION II LOT 44 LOT AREA 0.6292 ACRE SITE CLASS PS DESIGN FLOW 360 L.T.A.R. 0.30 GPD/FT²

Septic Tank: 1000 Gallons; STB 825 Date 4-8-00

Pump Tank: ____ Gallons; PT ____ Date ____

Pump Make: ____ Model ____ Serial No ____

Nitrification Field: No Fields 1 Square Feet 1200 Linear Feet 400

No Lines FIVE Trench Width 36" Max Trench Bottom Depth 36" Gravel Depth 12"

☑ New System ☐ Repair System Type: I (II) III, IV, V, VI

System Description: CONVENTIONAL GRAVITY

Repair System Description: 50% REDUCTION LOW PRESS.

Maintenance Agreement Required: ☐ Yes ☑ No

☑ House/Mod. Home No. Bedrooms 3

☐ Mobile Home No. Bathrooms 2

☐ Business No. Employees ____

☐ Other ____


☐ Slab ☑ Crawl Space ☐ Basement w/plumbing ☐ Basement wo/plumbing

Water Supply: ☐ Individual ☑ Public ☐ Community


Comments/Conditions: RAKE TRENCH SIDEWALLS WHERE SMEARING OCCURS & APPLY A LIGHT DUSTING OF LIME PRIOR TO INSTALLING STONE.

Comments/Conditions ① SEPTIC TANK RELOCATED W/O PRIOR APPROVAL FROM HEALTH DEPT. ② SEPTIC TANK W/ MARKER INSTALLED USING "POLYLOK" FITTER

INITIAL SITE SKETCH SCALE: 1"=40'

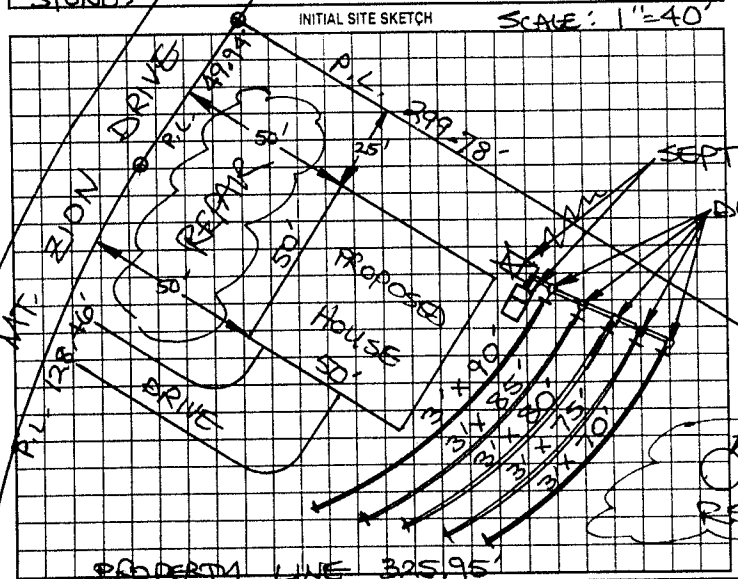


AS BUILT SKETCH

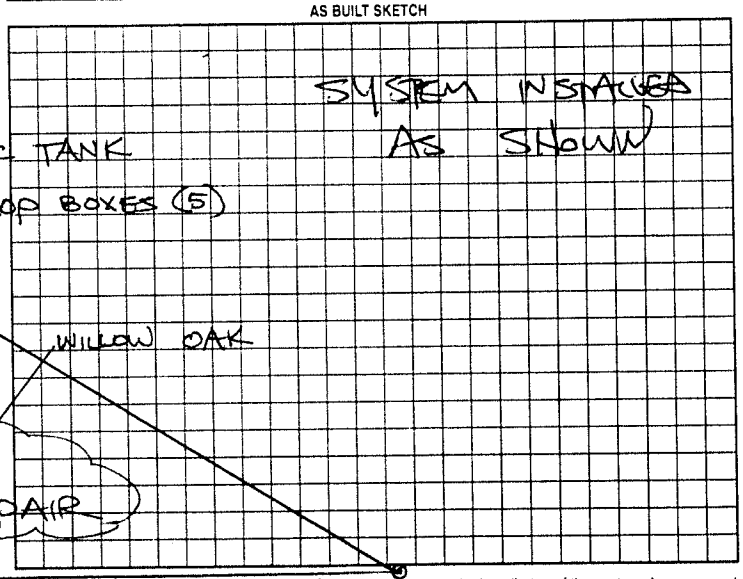


Permit can be suspended or revoked if any false information is supplied toward securing the permit/any unauthorized changes are made to the site/any unauthorized changes are made in the installation of the system. Improvement Permit with plat valid without expiration. Improvement Permit with site plan valid for sixty months. Authorization to Construct is valid for a period equal to that of Improvement Permit – not to exceed sixty months.

Signed: Roger Cecil date 4/19/00 Installed by: ROWAN SEPTIC TANK

Improvement Permit by: STEVE HEDRICK date 4-15-00 Operation Permit by: STEVE HEDRICK date 6-6-00

Authorization to Construct by: STEVE HEDRICK date 4-15-00 Existing System Inspection by: ____ date ____

HEALTH DEPT. COPY: WHITE OWNER COPY (FINAL): YELLOW OWNER COPY (INITIAL): PINK