330 400

IREDELL COUNTY HEALTH DEPARTMENT

STATESVILLE 704-878-5305 MOORESVILLE 704-664-5281

IMPROVEMENT PERMIT / AUTHORIZATION TO CONSTRUCT / OPERATION PERMIT / EXISTING SYSTEM INSPECTION

PERMIT# 089356 PIN# 4757352459 (pt) DATE September 5 00

OWNER OR CONTRACTOR Divieland Inc. / Conger, Cecil PHONE: Business 202-4971 Home

ADDRESS 4474 LAKE Dr. Sherrills Ford 28673

LOCATION 2 N. TL Bethany Rd. TR Gilead TR Berea TL Mt Zion on Right

SUBDIVISION Bethany Trace BLOCK / SECTION II LOT 46 LOT AREA .8789 Ac SITE CLASS. PS DESIGN FLOW 360gpd L.T.A.R. .25-.35 gpd/sq ft

Septic Tank: 1000 Gallons; STB 825 Date 9/20/00
Pump Tank: Gallons; PT Date
Pump Make: Model Serial No.
Nitrification Field: No Fields 1 Square Feet 1260 Linear Feet 420
No Lines 6@70' Trench Width 36" Max Trench Bottom Depth 36"

☑ New System ☐ Repair System Type: I, II, III, IV, V, VI
System Description: Gravity Conventional
Repair System Description: SAME
Maintenance Agreement Required: ☐ Yes ☑ No

☑ House/Mod. Home No. Bedrooms 3
☐ Mobile Home No. Bathrooms 2
☐ Business No. Employees
☐ Other


Water Supply: ☐ Individual ☑ Public ☐ Community

Gravel Depth 12" ☐ Slab ☑ Crawl Space ☐ Basement w/plumbing ☐ Basement wo/plumbing


Comments:/Conditions:

Comments:/Conditions:

INITIAL SITE SKETCH

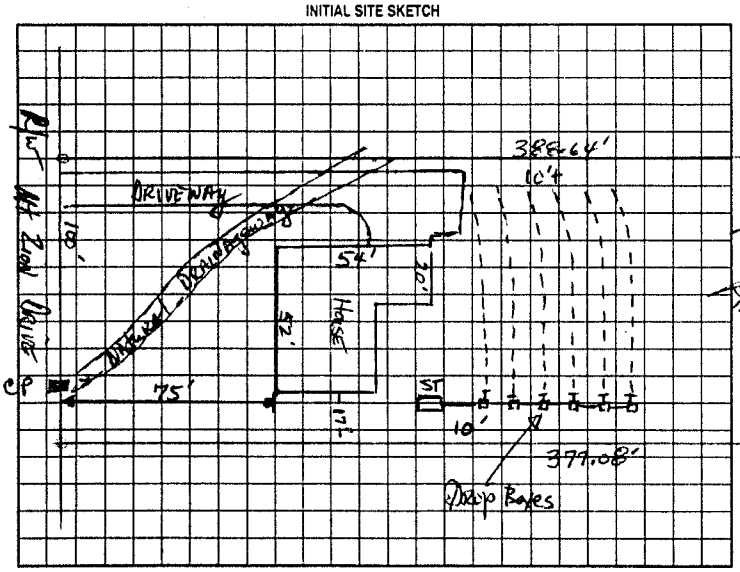

AS BUILT SKETCH

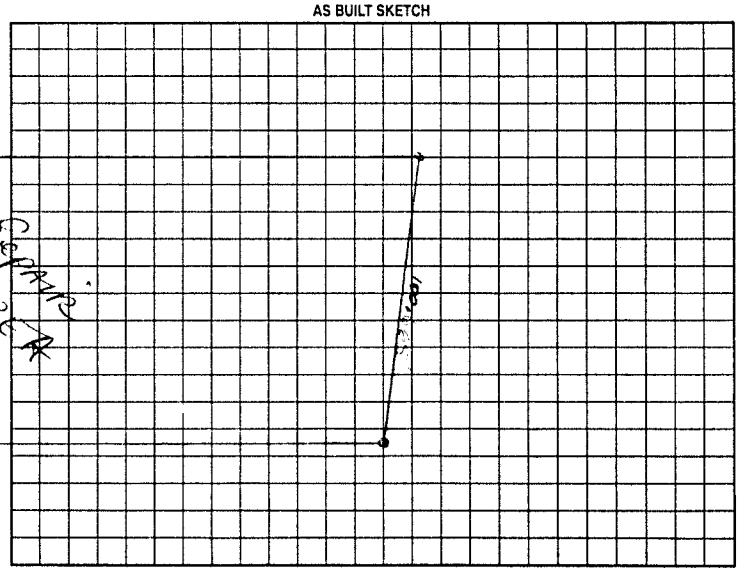

Permit can be suspended or revoked if any false information is supplied toward securing the permit/any unauthorized changes are made to the site/any unauthorized changes are made in the installation of the system. Improvement Permit with plat valid without expiration. Improvement Permit with site plan valid for sixty months. Authorization to Construct is valid for a period equal to that of Improvement Permit -- not to exceed sixty months.

Signed: [signature] date 9/6/00 Installed by: ROWAN SEPTIC

Improvement Permit by: [signature] date 9-5-00 Operation Permit by: C. Bly Jr RS date 11/14/00

Authorization to Construct by: [signature] date 9-5-00 Existing System Inspection by: date

HEALTH DEPT. COPY: WHITE OWNER COPY (FINAL): YELLOW OWNER COPY (INITIAL): PINK