IREDELL COUNTY HEALTH DEPARTMENT

STATESVILLE 704-878-5305 125.00 Paid MOORESVILLE 704-664-5281

IMPROVEMENT PERMIT / AUTHORIZATION TO CONSTRUCT / OPERATION PERMIT / EXISTING SYSTEM INSPECTION

PERMIT# 089355 PIN# 4757352459 (pt) DATE Jan 10, 01

OWNER OR CONTRACTOR Diversified Inc. PHONE: Business 202-4971 Home

ADDRESS 4474 LAKE DR. Sherrills Ford NC 28673

LOCATION 21 N TL Bethany Rd TR Gilead TR Bethel TR Mt Zion on Right

SUBDIVISION Bethany Trace BLOCK / SECTION II LOT 45 LOT AREA .90 AC SITE CLASS. PS DESIGN FLOW 360gpd L.T.A.R. ~.3

Septic Tank: 1000 Gallons. STB 825 Date 3-16-01

Pump Tank: Gallons; PT Date

Pump Make: Model Serial No.

Nitrification Field: No Fields 1 Square Feet 960 Linear Feet 320

No Lines 6 5 Trench Width 36" Max Trench Bottom Depth 36"

☑ New System ☐ Repair System Type: I. II. III. IV. V. VI

System Description: Gravity Innovative -25%red

Repair System Description: LP Panel Block

Maintenance Agreement Required: ☐ Yes ☑ No

Gravel Depth N/A ☐ Slab ☑ Crawl Space ☐ Basement w/plumbing ☐ Basement wo/plumbing

☐ House/Mod. Home No. Bedrooms 3

☐ Mobile Home No. Bathrooms 2

☐ Business No. Employees


☐ Other

Water Supply: ☐ Individual ☑ Public ☐ Community


Comments/Conditions: 53 CHAMBERS = 320'

Comments /Conditions: POLYLOK FILTER & MARKER INSTALLED AS SHOWN.

INITIAL SITE SKETCH 1"=50'

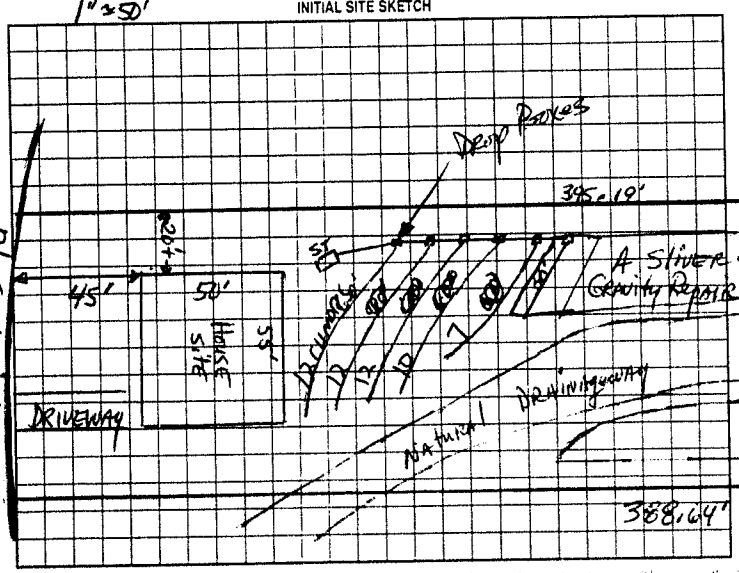

AS BUILT SKETCH

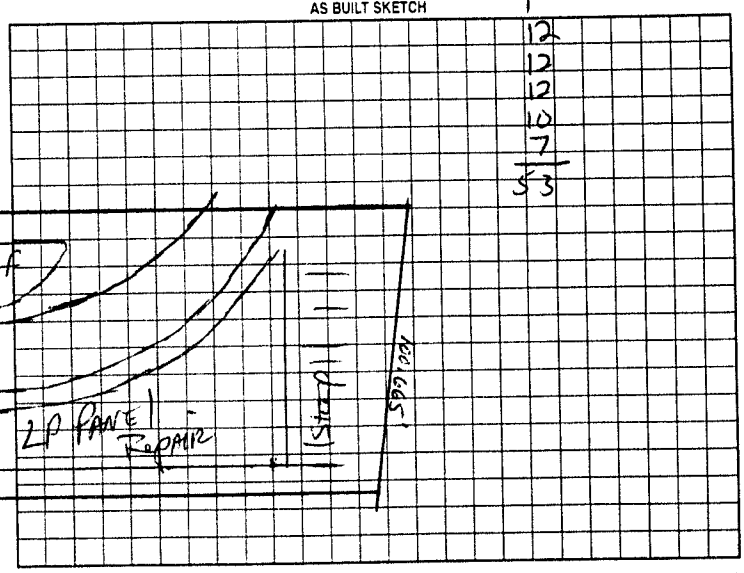

Permit can be suspended or revoked if any false information is supplied toward securing the permit/any unauthorized changes are made to the site/any unauthorized changes are made in the installation of the system. Improvement Permit with plat valid without expiration. Improvement Permit with site plan valid for sixty months. Authorization to Construct is valid for a period equal to that of Improvement Permit – not to exceed sixty months.

Signed: Ginger Green date 1/10/01

Improvement Permit by: Mark S. Hamm IRS date 1-10-01

Authorization to Construct by: STEVE HEDRICK date 1-10-01

Installed by: ROWAN SEPTIC

Operation Permit by: Jon Cook RS date 6-24-01

Existing System Inspection by: date

HEALTH DEPT COPY WHITE OWNER COPY (FINAL) YELLOW OWNER COPY (INITIAL) PINK