IREDELL COUNTY HEALTH DEPARTMENT

STATESVILLE 704-878-5305 MOORESVILLE 704-664-5281

IMPROVEMENT PERMIT / AUTHORIZATION TO CONSTRUCT / OPERATION PERMIT / EXISTING SYSTEM INSPECTION

PERMIT# 089941 PIN# 4757352459 (pt) DATE July 20, 2000

OWNER OR CONTRACTOR Dixieland Inc. // Ginger Cook PHONE: Business 828-478-5331 Home

ADDRESS 4474 Lake Dr. Sherrills Ford N.C. 28673

LOCATION 21 N. TL Bethany Rd. TR Gilead TR Berea TL Mt Zion AT END on Right

SUBDIVISION Bethany Trace BLOCK / SECTION 4 LOT 42 LOT AREA 1.12 Ac SITE CLASS R5 DESIGN FLOW 360gpd L.T.A.R. .03

Septic Tank: 1000 Gallons; STB 825 Date 6/21/00

Pump Tank: Gallons; PT Date

Pump Make: Model Serial No

Nitrification Field: No Fields 1 Square Feet 1200 Linear Feet 400

No Lines 4@100 Trench Width 36" Trench Bottom Depth 36" Gravel Depth 12"

☑ New System ☐ Repair System Type: I II III IV V VI

System Description: Gravity Conventional

Repair System Description: same

Maintenance Agreement Required: ☐ Yes ☑ No

☑ House/Mod. Home No. Bedrooms 3

☐ Mobile Home No. Bathrooms 2

☐ Business No. Employees

☐ Other

☐ Slab ☑ Crawl Space ☐ Basement w/plumbing ☐ Basement wo/plumbing

Water Supply: ☐ Individual ☑ Public ☐ Community


Comments/Conditions:

288.28'

Comments/Conditions:

INSTALLER NOTE: Laterals to be installed between 30"-36" trench bottom depth.

INITIAL SITE SKETCH

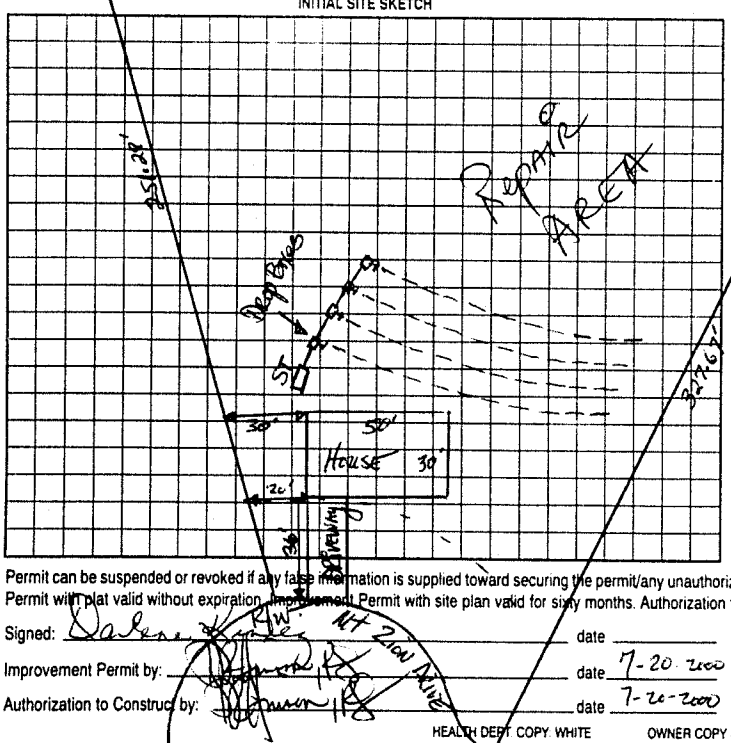

AS BUILT SKETCH

Permit can be suspended or revoked if any false information is supplied toward securing the permit/any unauthorized changes are made to the site/any unauthorized changes are made in the installation of the system. Improvement Permit will not be valid without expiration. Improvement Permit with site plan valid for sixty months. Authorization to Construct is valid for a period equal to that of Improvement Permit – not to exceed sixty months.

Signed: Darlene Hamlin date

Improvement Permit by: date 7-20-2000

Authorization to Construct by: date 7-26-2000

Installed by: Rowan Septic

Operation Permit by: RST date 9/12/00

Existing System Inspection by: date

HEALTH DEPT COPY: WHITE OWNER COPY (FINAL) YELLOW OWNER COPY (INITIAL) PINK