IREDELL COUNTY HEALTH DEPARTMENT - *ENVIRONMENTAL HEALTH* ☒ STATESVILLE OFFICE 704-878-5305 ☐ MOORESVILLE OFFICE 704-664-5281

IMPROVEMENT PERMIT / AUTHORIZATION TO CONSTRUCT (I) / OPERATION PERMIT (O) / EXISTING SYSTEM INSPECTION

PERMIT # 156036 PIN # 4757-37-4710 DATE 3-21-11

OWNER Countrytyme NC APPLICANT: Kyle + Emily McGee PHONE: Home/Cell # 704-252-0184 Business #

SITE ADDRESS 169 Ravencrest OWNER / APPLICANT ADDRESS 174 Lippard Springs Cir. Statesville, NC

SITE DIRECTIONS Hwy 21 N - 1.5 mile past Statesville Auto Auction - (L) @ Maple Creek Dr. (L) @ Ravencrest - Lot on (R)

SUBDIVISION The Highlands @ Maple Creek BLOCK / SECTION n/a LOT # 10 LOT AREA 1.5144 DESIGN FLOW 480 L.T.A.R. @ .25

Septic Tank 1000 Gallons: STB 825 Date 7-14-11

Pump Tank Gallons: P T Date

Pump Make Model Serial #

No. Nitrification Fields: 1 No. Lines 4 Linear Feet 480

Trench Width 36" Max. Trench Bottom Depth 36" Gravel Depth n/a

☒ New System ☐ Repair ☐ Expansion System Type I II (III) IV V VI

System Description: 25% Reduction Gravity

Repair System Description: @ 25% Reduction Pump

Maintenance Agreement Required ☐ YES ☒ NO

☒ GRAVITY ☐ PRESSURE

☒ Residence No. Bedrooms 4

☐ Business No. Persons

☐ Other No. Employees

☐ Slab ☐ Crawl Space

☒ Basement w/plumbing ☐ Basement w/o plumbing


Water Supply: ☐ Private ☒ Public ☐ Community

Comments / Conditions


Keep system >5' from any foundation including deck.

Tot-Tite Filter

INITIAL SITE SKETCH

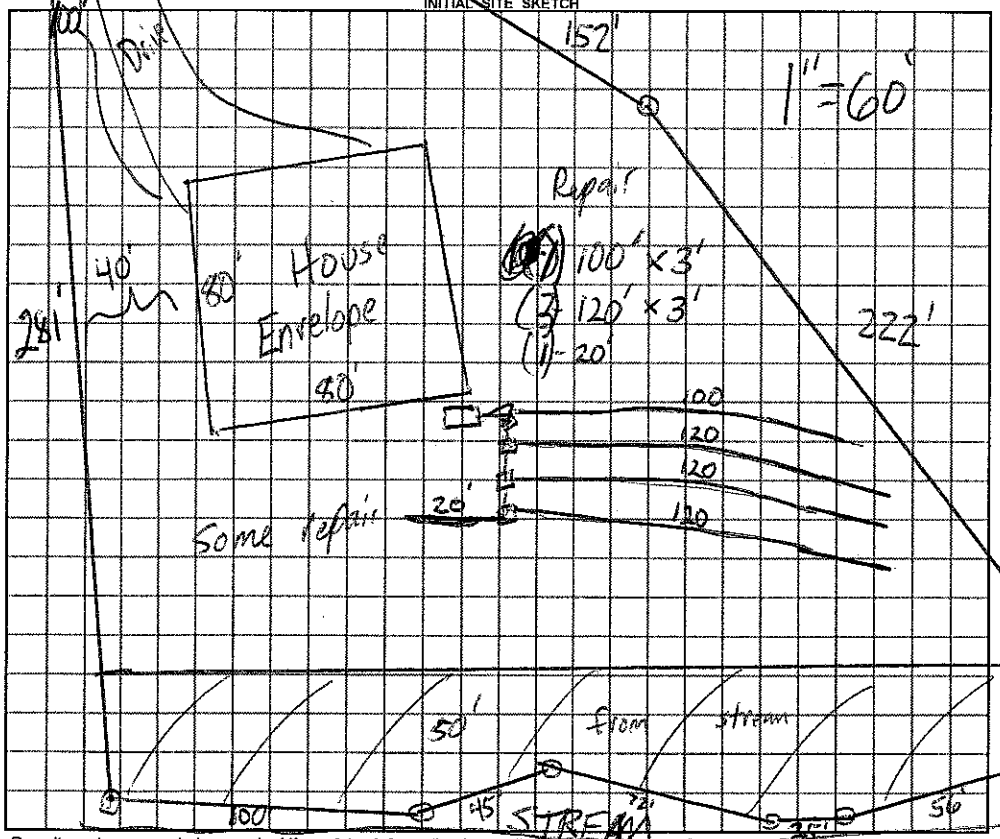

AS BUILT SKETCH

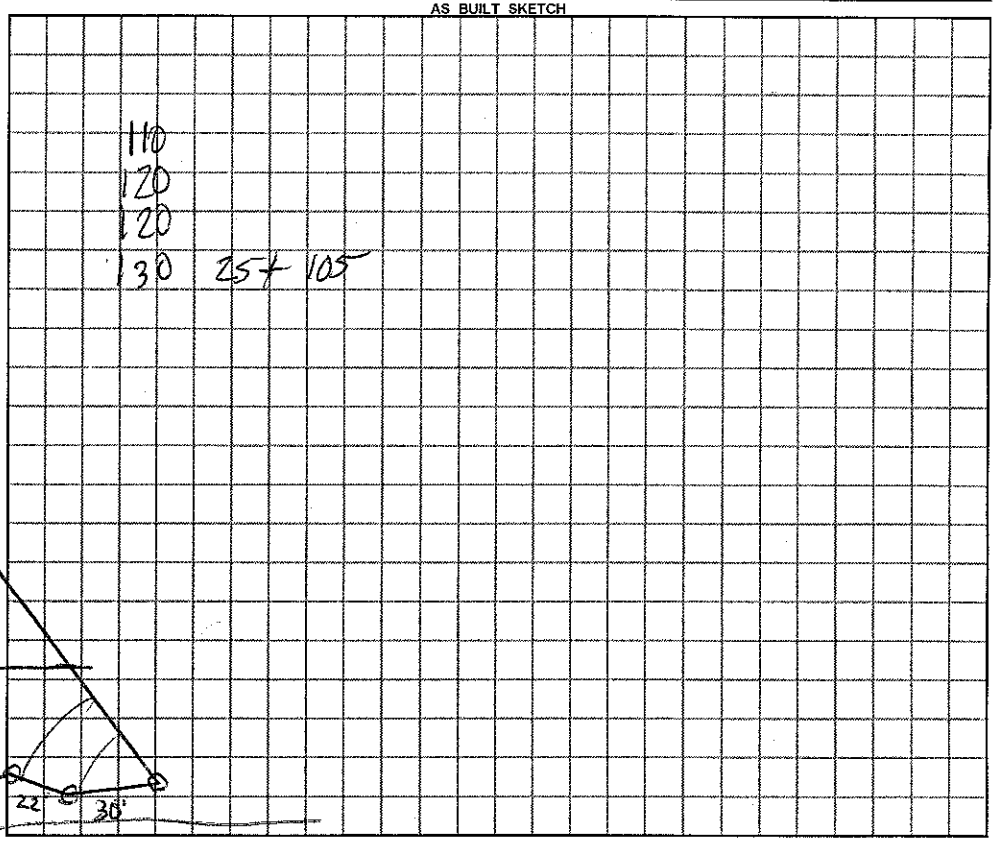

Permit can be suspended or revoked if any false information is supplied toward securing the permit / any unauthorized changes are made to the site / any unauthorized changes are made in the installation of the system.

☐ ***IMPROVEMENT PERMIT*** with plat valid without expiration. ☒ ***IMPROVEMENT PERMIT*** with ~~plat valid without expiration~~ site plan valid 60 mo. ☒ ***AUTHORIZATION TO CONSTRUCT*** valid for period equal to IMPROVEMENT PERMIT - not to exceed 60 mo.

Owner / Applicant Signature: Valerie Stevens Date 4-28-11 Installed by: Rowan Septic

IMPROVEMENT PERMIT by: James Ross ***REHS*** Date 3-21-11 OPERATION PERMIT by: James Ross ***REHS*** Date 9-19-11

AUTHORIZATION TO CONSTRUCT by: James Ross ***REHS*** Date 3-21-11 Existing System Inspected by: ***REHS*** Date

YOU SHOULD CONTACT A LOCATOR SERVICE PRIOR TO ANY EXCAVATION

White Copy – Environmental Health YELLOW COPY (Final) Owner / Applicant PINK COPY (Initial) Owner / Applicant