IREDELL COUNTY HEALTH DEPARTMENT

STATESVILLE 704-878-5305 MOORESVILLE 704-664-5281

IMPROVEMENT PERMIT / AUTHORIZATION TO CONSTRUCT / OPERATION PERMIT / EXISTING SYSTEM INSPECTION

PERMIT# 146235 PIN# 4757-37-4809 DATE 11-9-2007

OWNER OR APPLICANT (JEREMY SHREWSBURY) PHONE: Business 336-696-2234 Home 336-902-7667

ADDRESS 184 NORTHVIEW DRIVE HAYES NC 28635

LOCATION US21 NORTH TL MAPLE CREEK DR, TL RAVENCREST DRIVE, LOT AT END ON CUL-DE-SAC

SUBDIVISION HIGHLANDS @ MAPLE CREEK SECTION ____ LOT 9 LOT AREA 1.448 ACRES SITE CLASS. PS1 DESIGN FLOW 480 L.T.A.R. 0.30 GPD/FT²

Septic Tank: 1000 Gallons: STB 760 Date 10-5-09

Pump Tank: ____ Gallons: PT ____ Date ____

Pump Make: ____ Model ____ Serial No. ____

Nitrification Field: No Fields ____ Square Feet 1600 Linear Feet 400

No Lines THREE Trench Width 36" Max Trench Bottom Depth 36" Gravel Depth N/A

☑ New System ☐ Repair ☐ Expansion System Type: I II III IV V VI

System Description: 25% REDUCTION, GRAVITY

Repair System Description: 25% REDUCTION, PUMP

Maintenance Agreement Required: ☐ Yes ☑ No

☑ House/Mod. Home ☐ Mobile Home ☐ Business ☐ Other ____

No. Bedrooms 4 No. Persons ____ No. Employees ____


Water Supply: ☐ Individual ☑ Public ☐ Community

☑ Gravity ☐ Pressure ☐ Slab ☐ Crawl Space ☑ Basement w/plumbing ☐ Basement wo/plumbing


Comments:/Conditions: INSTALL 25% REDUCTION SYSTEM ON CONTOUR AS SHOWN. KEEP SYSTEM MINIMUM 50 FEET FROM BRANCH.

Comments:/Conditions: Red Filter

INITIAL SITE SKETCH ~SCALE: 1"=60' (THIS IS NOT A SURVEY)

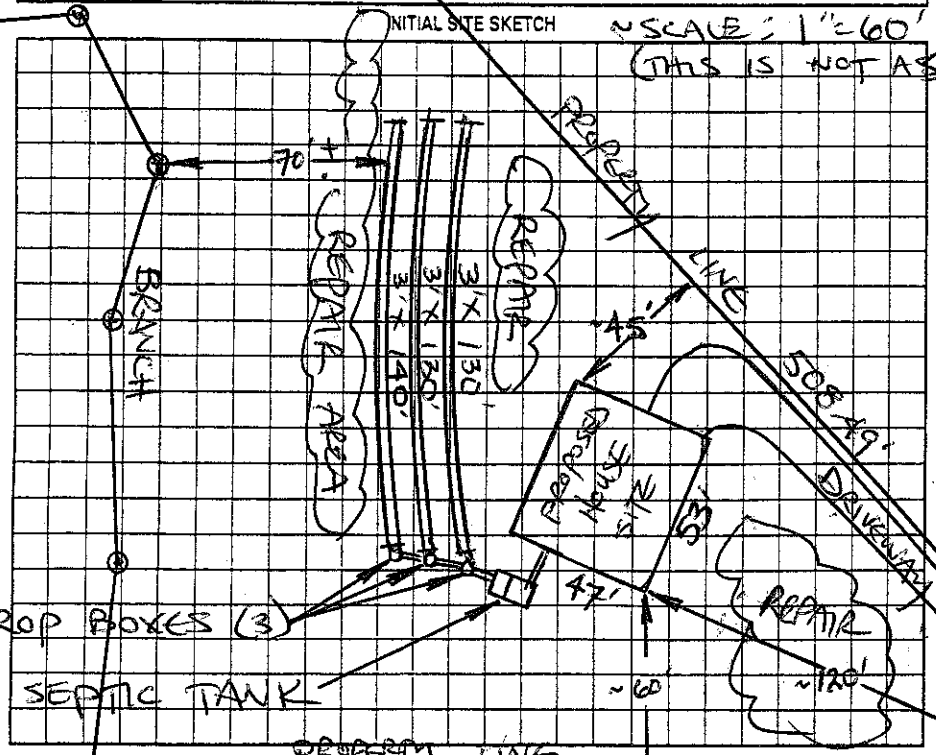

AS BUILT SKETCH

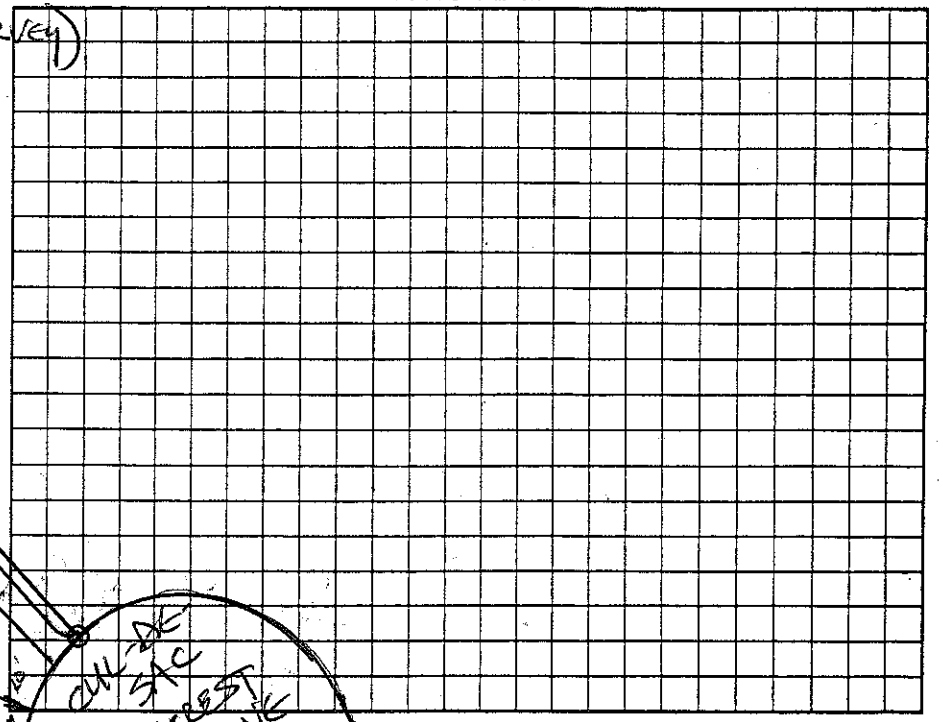

Permit can be suspended or revoked if any false information is supplied toward securing the permit/any unauthorized changes are made to the site/any unauthorized changes are made in the installation of the system. Improvement Permit with plat valid without expiration ☐ Improvement Permit with site plan valid for sixty months ☑ Authorization to Construct is valid for a period equal to that of Improvement Permit – not to exceed sixty months.

Signed: ____ date 11/9/07 Installed by: Darryl Salmon Grading & Hauling

Improvement Permit by: STEVE HEDRICK date 11-9-2007 Operation Permit by: ____ date 3-23-09

Authorization to Construct by: STEVE HEDRICK date 11-9-2007 Existing System Inspection by: ____ date ____

HEALTH DEPT. COPY: WHITE OWNER COPY (FINAL): YELLOW OWNER COPY (INITIAL): PINK