IREDELL COUNTY HEALTH DEPARTMENT

STATESVILLE 704-878-5305 (@) (@) MOORESVILLE 704-664-5281

IMPROVEMENT PERMIT / AUTHORIZATION TO CONSTRUCT / OPERATION PERMIT / EXISTING SYSTEM INSPECTION

PERMIT# 150498 PIN# 4757375305

OWNER OR APPLICANT Americas Home Place Inc. DATE 6-3-08

ADDRESS Wilderman Trail, Statesville 28625 PHONE: Business 704 872 4400 Home 704 881 2232

LOCATION Hwy 21N, to (R) on Maple Creek Drive to (L) on Ravencrest to (L) Wilderman - lot 13 on right

SUBDIVISION Highlands BLOCK / SECTION LOT 13 LOT AREA 1.31 SITE CLASS. RS DESIGN FLOW 360 L.T.A.R. .3

Septic Tank: 1000 Gallons: STB 760 Date 3-26-08

Pump Tank: Gallons; PT Date

Pump Make: Model Serial No.

Nitrification Field: No Fields 1 Square Feet 1200 Linear Feet 300

No Lines 4 Trench Width 36" Max Trench Bottom Depth 36" Gravel Depth

☒ New System ☐ Repair ☐ Expansion System Type: I (II) III IV V VI

System Description: 25% Reduction Gravity

Repair System Description: Pump 25% Reduction - Ff per

Maintenance Agreement Required: ☐ Yes ☒ No

☒ Gravity ☐ Pressure

☒ House/Mod. Home No. Bedrooms 3

☐ Mobile Home No. Persons

☐ Business No. Employees

☐ Other

Water Supply: ☐ Individual ☒ Public ☐ Community

☐ Slab ☒ Crawl Space ☐ Basement w/plumbing ☐ Basement wo/plumbing


Comments:/Conditions.

(4) 3' x 75'


Comments:/Conditions:

Red Filter

INITIAL SITE SKETCH

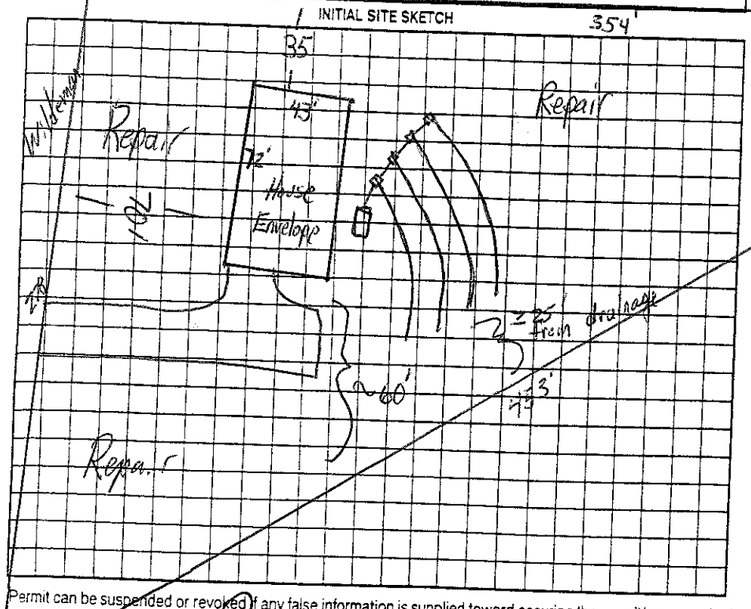

AS BUILT SKETCH

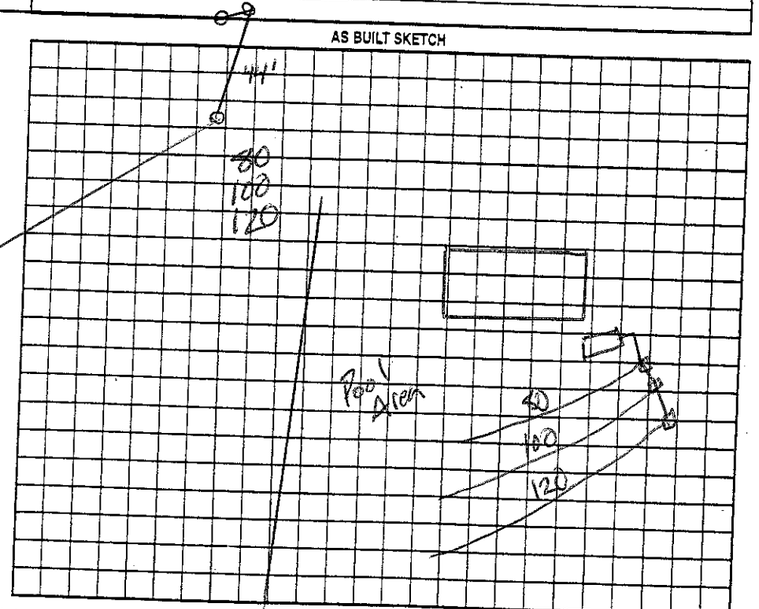

Permit can be suspended or revoked if any false information is supplied toward securing the permit/any unauthorized changes are made to the site/any unauthorized changes are made in the installation of the system. Improvement Permit with plat valid without expiration ☐ Improvement Permit with site plan valid for sixty months ☒ Authorization to Construct is valid for a period equal to that of Improvement Permit – not to exceed sixty months.

Signed: Chris Barge

Improvement Permit by: date 6-3-08

Authorization to Construct by: date 6-3-08

Installed by: A-1 Backhoe

Operation Permit by: date 6-24-08

Existing System Inspection by: date

HEALTH DEPT. COPY: WHITE OWNER COPY (FINAL): YELLOW OWNER COPY (INITIAL): PINK