12-1

IREDELL COUNTY HEALTH DEPARTMENT

STATESVILLE 704-878-5305 MOORESVILLE 704-664-5281

IMPROVEMENT PERMIT / AUTHORIZATION TO CONSTRUCT / OPERATION PERMIT / EXISTING SYSTEM INSPECTION

PERMIT # 153586 PIN # 4757378107 DATE 1-6-08

OWNER or APPLICANT Ian Cary PHONE: Business Home: 704 924 9363

OWNER or APPLICANT ADDRESS 121 Wildeman Trail

LOCATION / DIRECTIONS Hwy 21 N, (L) on Maple Creek, (L) on Ravencrest, (L) on Wildeman

SUBDIVISION Highlands BLOCK / SECTION LOT # 18 LOT AREA .94 DESIGN FLOW 480 L.T.A.R. .3

Septic Tank 1000 Gallons: STB 854 Date 1-15-13

Pump Tank 1000 Gallons: P T 1169 Date 10-4-12

Pump Make Model Serial #

Nitrification Field No Fields 1 No Lines 3 Linear Feet 400

Trench Width 36" Max. Trench Bottom Depth 36" Gravel Depth n/a

[X] New System [ ] Repair [ ] Expansion System Type I II (III) IV V VI

System Description: 25% Reduction Pump

Repair System Description: 50% Reduction LP

Maintenance Agreement Required [ ] YES [X] NO

[X] GRAVITY [ ] PRESSURE

[X] Residence No. Bedrooms 4

[ ] Business No. Persons

[ ] Other No. Employees

[ ] Slab [ ] Crawl Space


[X] Basement w/plumbing [ ] Basement w/o plumbing

Water Supply: [ ] Private [X] Public [ ] Community

Comments / Conditions

Comments / Conditions

INITIAL SITE SKETCH

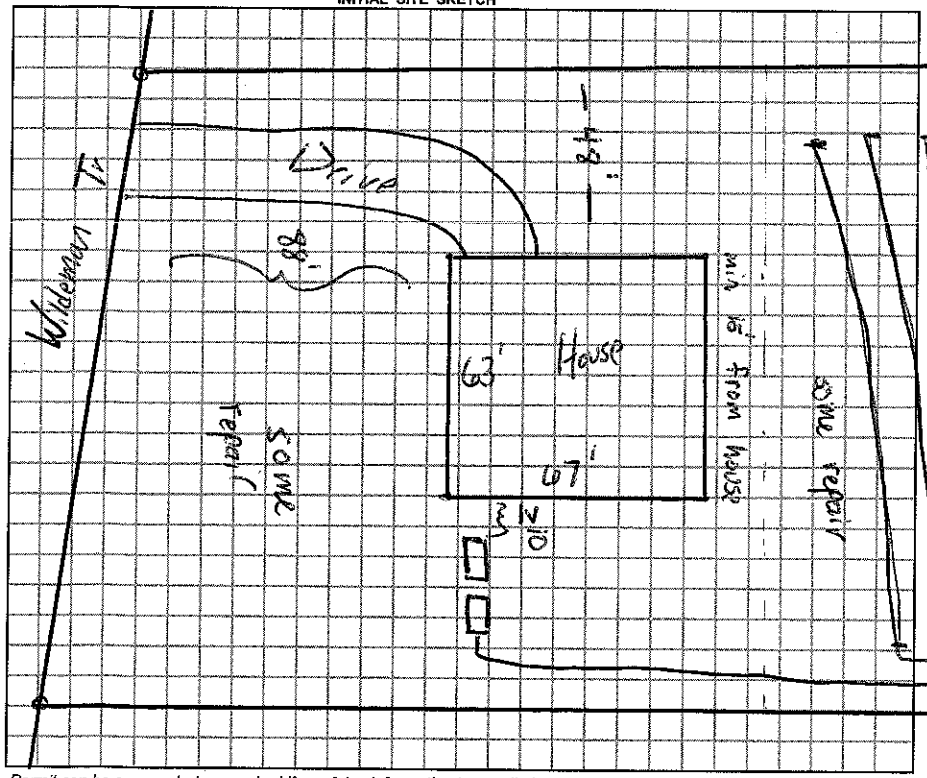

AS BUILT SKETCH

Permit can be suspended or revoked if any false information is supplied toward securing the permit / any unauthorized changes are made to the site / any unauthorized changes are made in the installation of the system.

[X] *IMPROVEMENT PERMIT w / plat valid without expiration.* [ ] *IMPROVEMENT PERMIT w / site plan valid for 60 mos.* [ ] *AUTHORIZATION TO CONSTRUCT valid for period equal to IMPROVEMENT PERMIT-not to exceed 60 mo.*

Owner / Applicant Signature: Ian Cary Date 2-20-09

Improvement Permit by: Date 1-6-08

Authorzation to Construct by: Date 9-5-12

YOU SHOULD CONTACT A LOCATOR SERVICE PRIOR TO ANY EXCAVATION.

Installed by: Vernon Blackburn / SDJ

Operation Permit by: Date: 4-26-13

Existing System Inspected by: Date:

WHITE COPY Environmental Health YELLOW COPY (Final) Owner / Applicant PINK COPY (Initial) Owner / Applicant