IREDELL COUNTY HEALTH DEPARTMENT

STATESVILLE 704-878-5305 (cd) MOORESVILLE 704-664-5281 (cd)

IMPROVEMENT PERMIT / AUTHORIZATION TO CONSTRUCT / OPERATION PERMIT / EXISTING SYSTEM INSPECTION

PERMIT # 156717 PIN # 4757-37-8299 DATE JUNE 17 2009

OWNER or APPLICANT TOM PALMER HOMES, INC PHONE: Business 704-651-0706 Home: 704-780-1448

OWNER or APPLICANT ADDRESS 125 O'HENRY AVE, DAVIDSON, NC 28036

LOCATION / DIRECTIONS US 21 NORTH, TL MAPLE CREEK, TL RAVEN CREST TL WILDEMAN, 3RD LOT ON RIGHT

SUBDIVISION HIGHLANDS @ MAPLE CREEK BLOCK / SECTION LOT # 19 LOT AREA 0.759 DESIGN FLOW 480' L.T.A.R. 0.30 GPD/FT2


Septic Tank	1000	Gallons: STB	572	Date	1-23-09	☑ New System	☐ Repair	☐ Expansion System	Type I II III IV V VI
Pump Tank		Gallons: PT		Date		System Description:	25% REDUCTION, GRAVITY		
Pump Make		Model		Serial #		Repair System Description:	50% REDUCTION, PRESSURE		
Nitrification Field	No Fields 1	No Lines	FIVE	Linear Feet	400	Maintenance Agreement Required	☐ YES	☑ NO	
Trench Width	36"	Max. Trench Bottom Depth	36"	Gravel Depth	N/A	☑ GRAVITY	☐ PRESSURE		

☑ Residence	No. Bedrooms	4	Water Supply	
☐ Business	No. Persons		☐ Private	
☐ Other	No. Employees		☐ Public	
☐ Slab	☐ Crawl Space		☐ Community	
☐ Basement w/plumbing	☐ Basement w/o plumbing			


Comments / Conditions: INSTALL 25% REDUCTION SYSTEM ON CONTOUR AS FLAGGED ON SITE.

Comments / Conditions: Red Soil Type

INITIAL SITE SKETCH

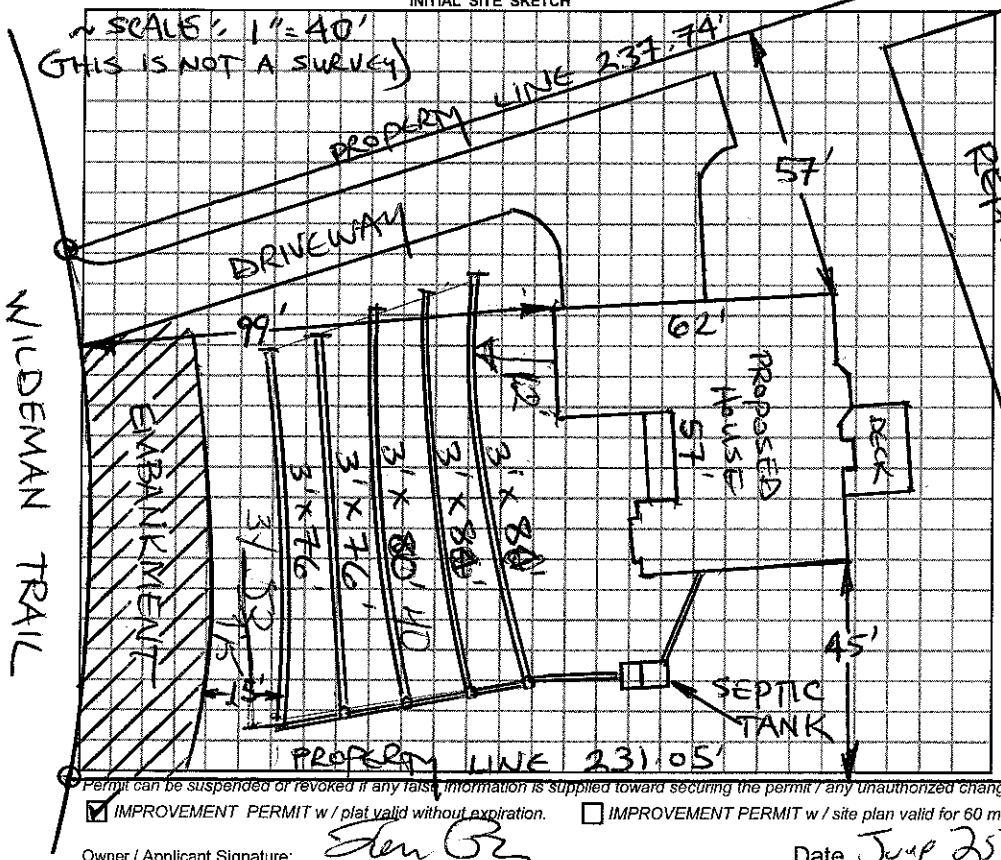

AS BUILT SKETCH

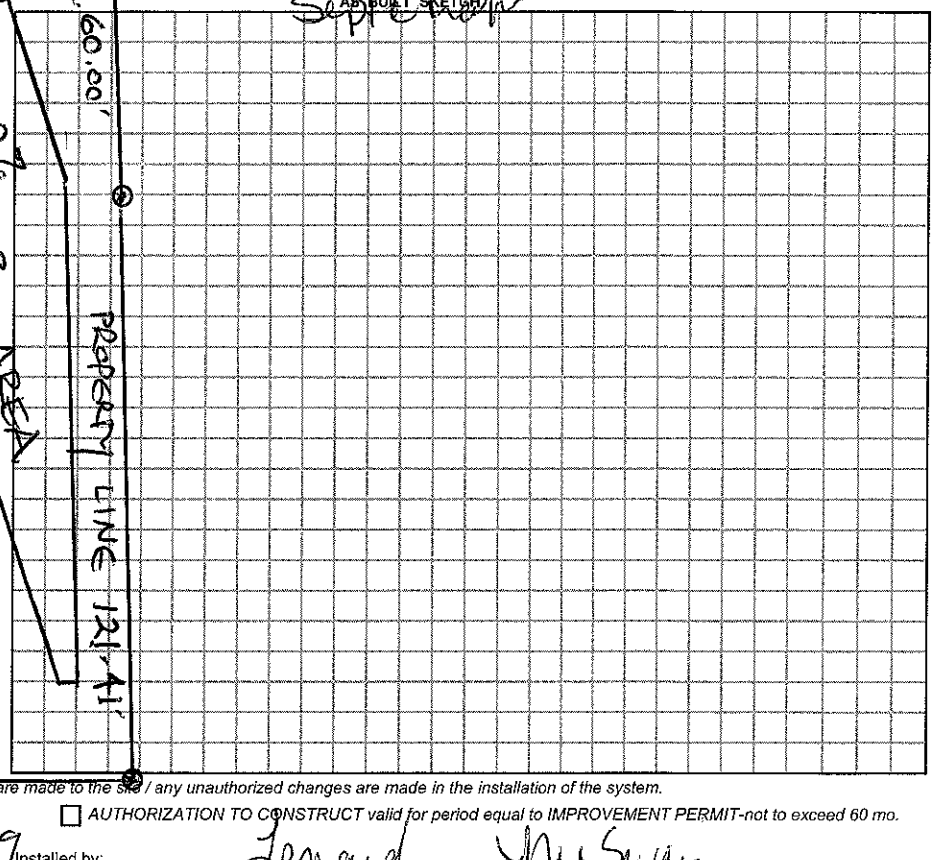

Permit can be suspended or revoked if any false information is supplied toward securing the permit / any unauthorized changes are made to the site / any unauthorized changes are made in the installation of the system.

☑ *IMPROVEMENT PERMIT w / plat valid without expiration.* ☐ *IMPROVEMENT PERMIT w / site plan valid for 60 mos.* ☐ *AUTHORIZATION TO CONSTRUCT valid for period equal to IMPROVEMENT PERMIT-not to exceed 60 mo.*

Owner / Applicant Signature: [signature] Date June 25,09 Installed by: Leonard McSwain

Improvement Permit by: STEVE HENDRICK Date JUNE 17,09 Operation Permit by: [signature] Date: 11-5-09

Authorization to Construct by: STEVE HENDRICK Date JUNE 25,09 Existing System Inspected by: Date:

YOU SHOULD CONTACT A LOCATOR SERVICE PRIOR TO ANY EXCAVATION.

WHITE COPY Environmental Health YELLOW COPY (Final) Owner / Applicant PINK COPY (Initial) Owner / Applicant