ICHD - ENVIRONMENTAL HEALTH DIVISION

Statesville Office (704) 878-5305 (BB) Mooresville Office (704) 660-3625 PERMIT # 305920

SEPTIC: IMPROVEMENT PERMIT / AUTHORIZATION TO CONSTRUCT / OPERATION PERMIT / EXISTING SYSTEM

PIN # 4757378868 ✓

APPLICANT/OWNER: Dixieland Inc APPLICANT ADDRESS: 851 Tomlin Mill Rd 28625

SITE ADDRESS: 162 Ravenerest Dr Statesville NC 28625 PHONE: 704-202-4971 ALT. PHONE –

SITE DIRECTIONS: Ex. I 54 I 77 Hwy 21 N Maple Creek Subdiv L on Ravenerest L on R SAP CONTROLLED: ☐ YES ☒ NO


SUBDIVISION: The Highlands @ Maple Creek SECTION: – LOT # 6 LOT AREA: 1.12 Acre DESIGN FLOW: 480 gpd L.T.A.R.: .3

Septic Tank	1000	(gal)	STB	760	Date	8-24-2020	☒ New System	☐ Repair	☐ Expansion	System Type: I II III IV V VI	
Pump Tank		(gal)	PT		Date		System Description:	25% Reduction			
Pump Make			Model		Serial #		Repair System Description:	50% Reduction			
# Nitrification Fields	1	# Lines	4		Linear Ft.	400	Maintenance Agreement Required:	☐ YES	☒ NO		
Trench Width	36"	Trench Bottom Depth(~~Low side~~)		Max 36	Gravel Depth	–		☒ GRAVITY	☐ PRESSURE		

☒ Residence	No. Bedrooms	4	Water Supply	
☐ Business	No. Persons	8	☐ Private	
☐ Other	No. Employees		☐ Public	
☐ Slab	☒ Crawl Space		☐ Community	
☐ Basement w/plumbing			☐ Basement w/o plumbing	


Comments / Conditions: Install Drainline on contour of land and use serial distribution

INITIAL SITE SKETCH

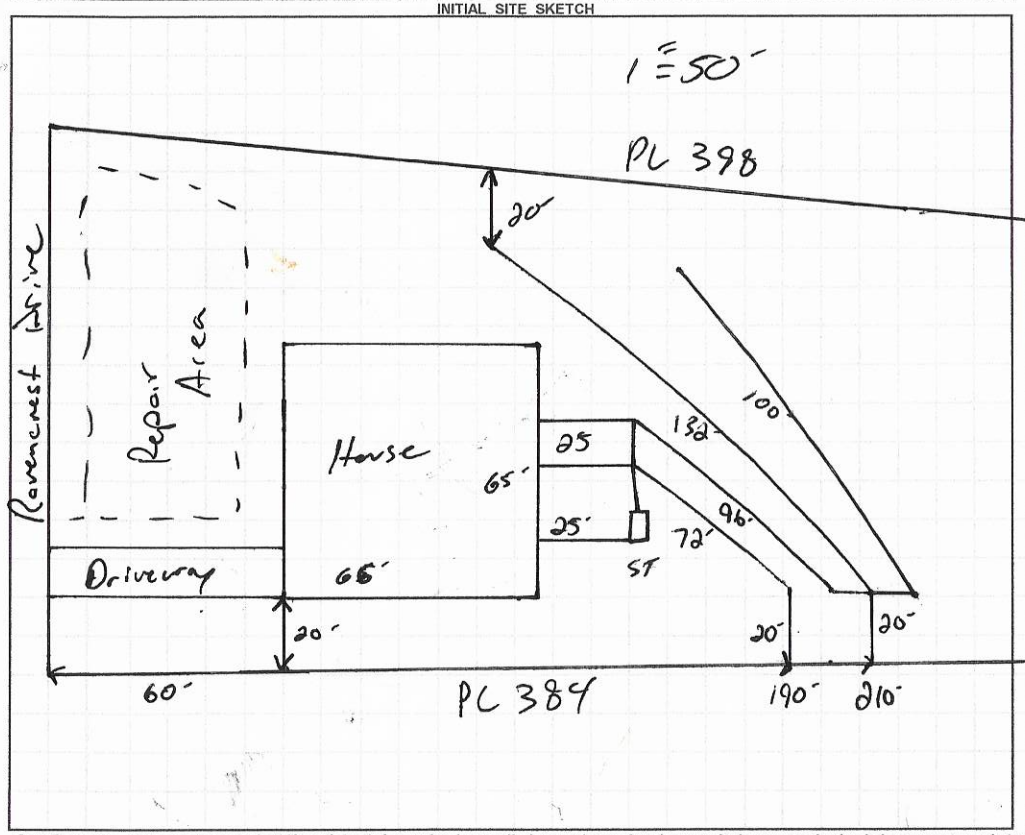

AS BUILT SKETCH

FOR SEPTIC INSPECTION CALL: 704-664-3703 between 8am-9am the day the inspection is needed. Be sure to speak with an inspector to confirm your time.

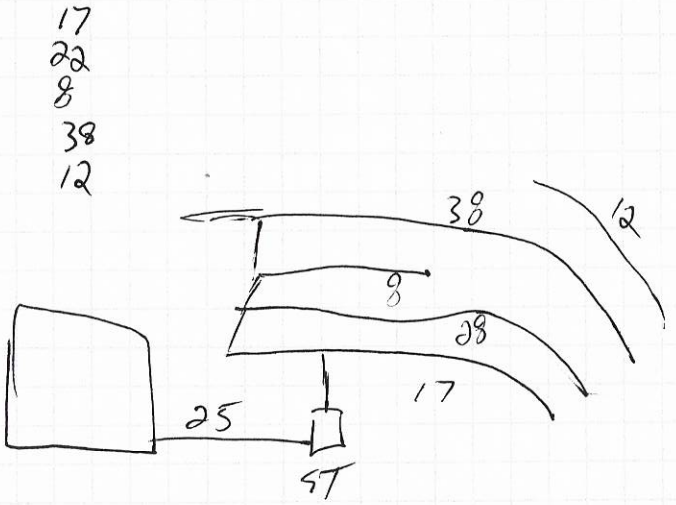

Permit can be suspended or revoked if any false information is supplied toward securing the permit / any unauthorized changes are made to the site / any unauthorized changes are made in the installation of the system. CONTACT A LOCATOR SERVICE PRIOR TO ANY EXCAVATION

☐ **IMPROVEMENT PERMIT** *with plat valid without expiration.* ☑ **IMPROVEMENT PERMIT** *with site plan valid for 60 mos.* ☑ **AUTHORIZATION TO CONSTRUCT** *valid for period equal to IMPROVEMENT PERMIT--not to exceed 60 mo.*

Owner / Applicant Signature: Katrina C Dixon Date: 5/19/2020 Installed by: Jake Williams

IMPROVEMENT PERMIT by: Date: 5-18-2020 OPERATION PERMIT by: Date: 11-6-2020


AUTHORIZATION TO CONSTRUCT by: Date: 5-18-2020 Existing System Inspected by: Date:

FOR SEPTIC FINAL INSPECTION: CALL 704-664-3703 between 8am-9am the day the inspection is needed.

CONNECTGIS WEB HOSTING


Iredell County

Iredell
Printed January 06, 2020
See Below for Disclaimer

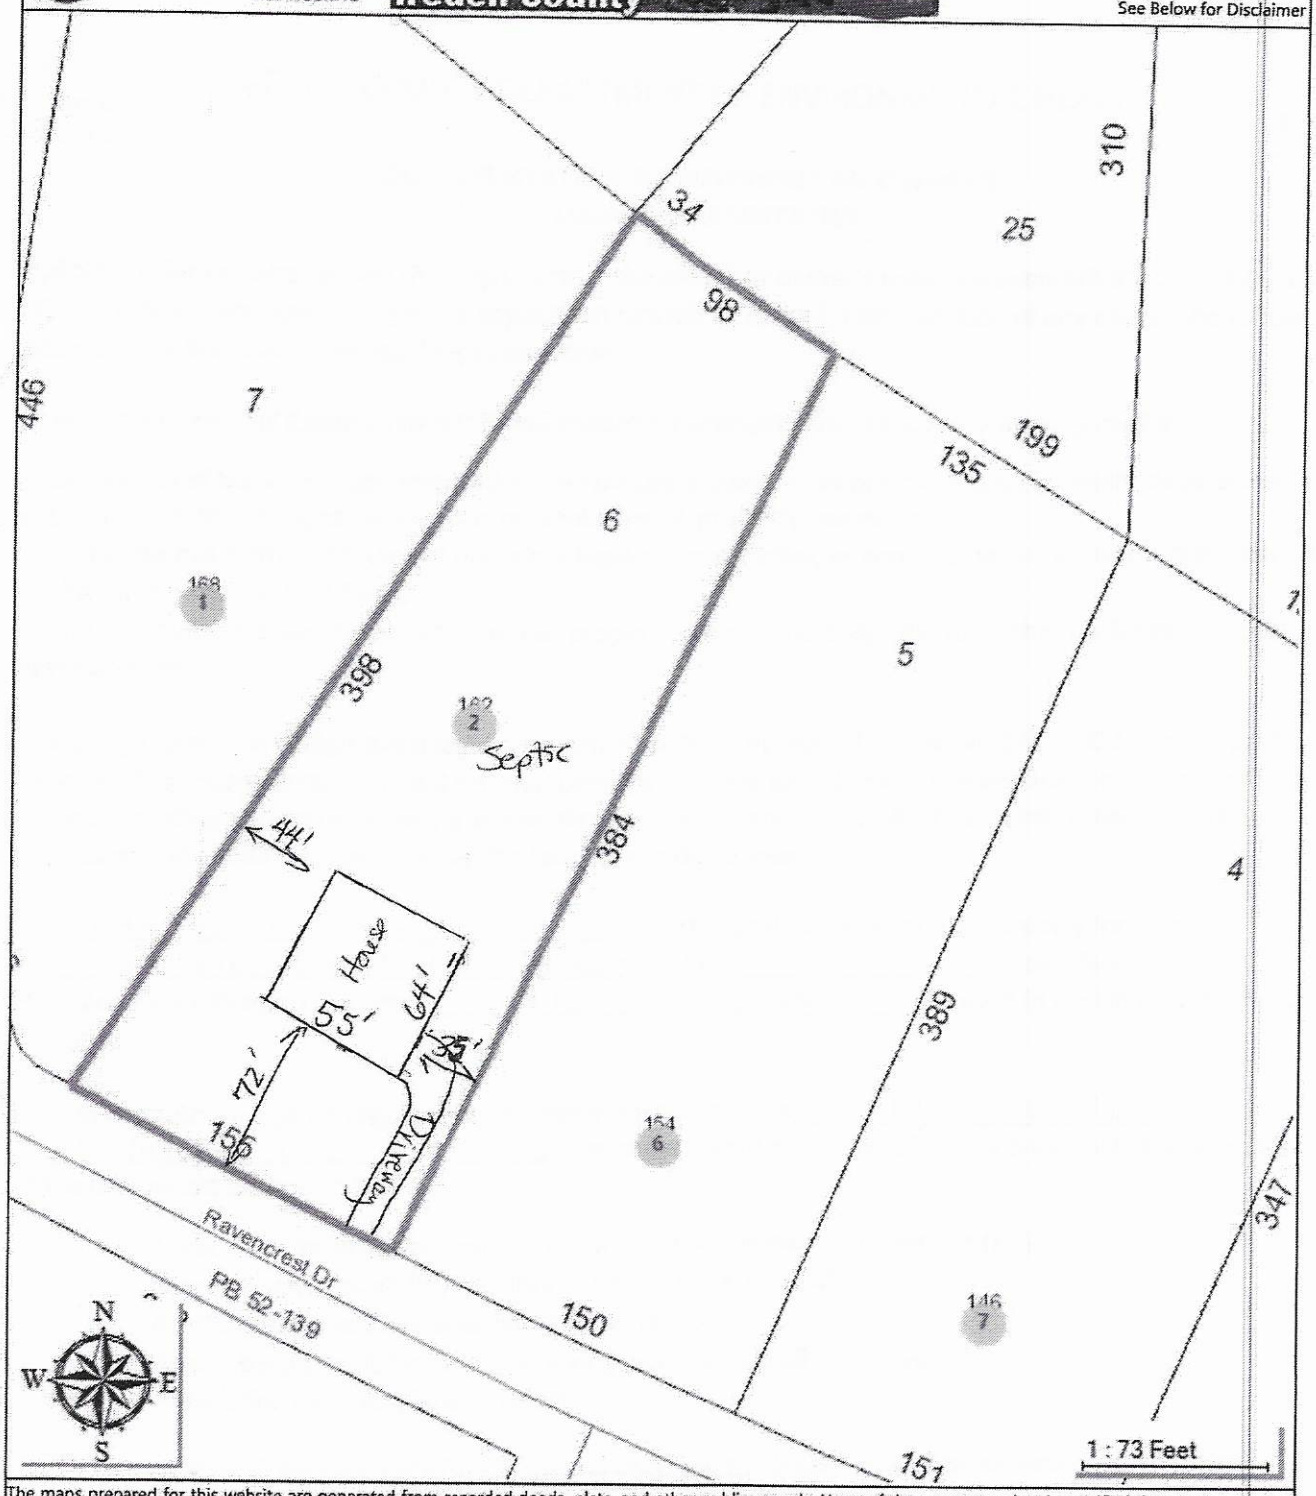

The maps prepared for this website are generated from recorded deeds, plats, and other public records. Users of these maps are hereby notified that the information provided herein should be verified. Iredell County assumes no legal responsibilities for any of the information contained on this site. Users are advised that the use of any of this information is at their own risk. All maps on this site were prepared using a 1000â€™ Grid based upon the North Carolina State Plane Coordinate System from the 1983 North American Datum. The delinquent real property tax overlay is updated monthly. The information presented is not intended to be used or relied upon as official notice of tax liens. For additional information regarding delinquent taxes, contact the Iredell County Tax Collector's Office.

ZONING DISCLAIMER

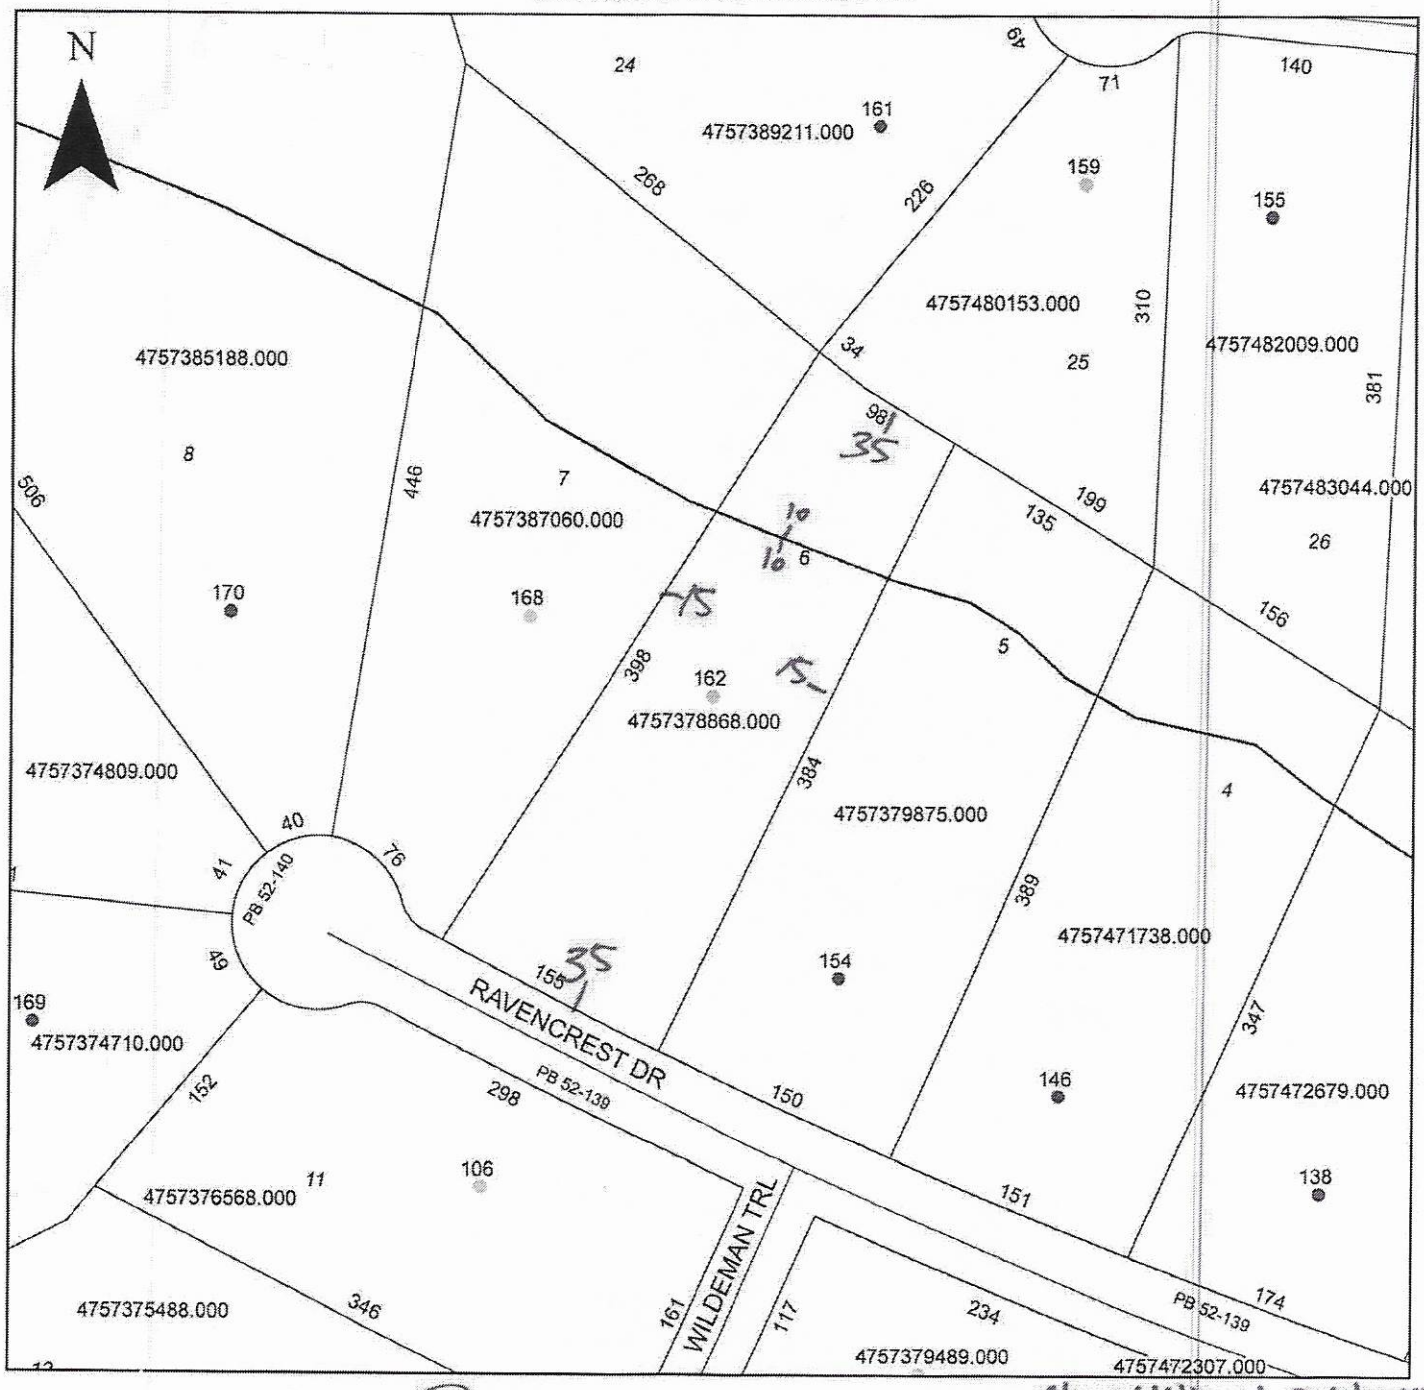

Property Address 162 Ravencrest Dr.

No additional setbacks on stream. Per William 10ft. for utilities easement

The applicant certifies that there are no deed restrictions, contractual agreements or governmental regulations of any kind that interfere with or prohibit the use of the property or the use for which this permit is requested. Applicant further acknowledges that the enforcement of deed restrictions, plat conditions, and other contractual agreements will not be undertaken by Iredell County and is the sole responsibility of the affected parties.

Regina Dudley

Applicant

1/7/2020

Date