IREDELL COUNTY HEALTH DEPARTMENT

STATESVILLE 704-878-5305 | MOORESVILLE 704-664-5281

IMPROVEMENT PERMIT / AUTHORIZATION TO CONSTRUCT / OPERATION PERMIT / EXISTING SYSTEM INSPECTION

PERMIT # 163289 PIN # 4757-37-9051 DATE 12 October 10

OWNER or APPLICANT Joseph Fusco PHONE: ~~Business~~ cell (401) 617-4321 Home: (704) 380-4598

OWNER or APPLICANT ADDRESS 253 Maple Creek Dr.

LOCATION / DIRECTIONS Hwy 21N TL Maple Creek TL Ravencrest TL Sandalwood Cir. on Rt.

SUBDIVISION The Highlands BLOCK / SECTION LOT # 27 LOT AREA @.9 Ac. DESIGN FLOW 360 g/d L.T.A.R. 0.3 g/ft²/d

Septic Tank 1000 Gallons: STB 794 Date 4-3-11

Pump Tank Gallons: P.T. Date

Pump Make Model Serial #

Nitrification Field No Fields 1 No Lines 4 Linear Feet 300

Trench Width 36" Max. Trench Bottom Depth 36" Gravel Depth N/A

☑ New System ☐ Repair ☐ Expansion System Type I II ⓘ IV V VI

System Description: 25% Reduction

Repair System Description: 25% Reduction

Maintenance Agreement Required ☐ YES ☑ NO

☑ GRAVITY ☐ PRESSURE

☑ Residence No. Bedrooms 3

☐ Business No. Persons

☐ Other No. Employees

☐ Slab ☑ Crawl Space

☐ Basement w/plumbing ☐ Basement w/o plumbing

Water Supply: ☐ Private ☑ Public ☐ Community

Comments / Conditions


1"=50'

Comments / Conditions

Polylok Filter tee


ST with manhole

INITIAL SITE SKETCH

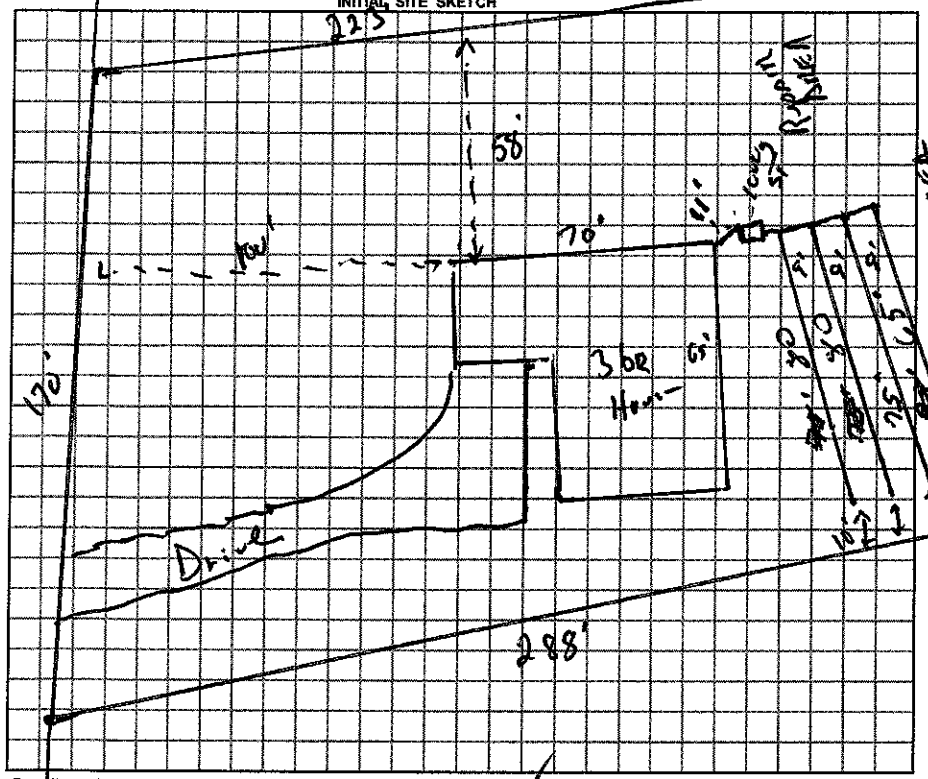

AS BUILT SKETCH

#Bio Rec 36 w/end caps distribution

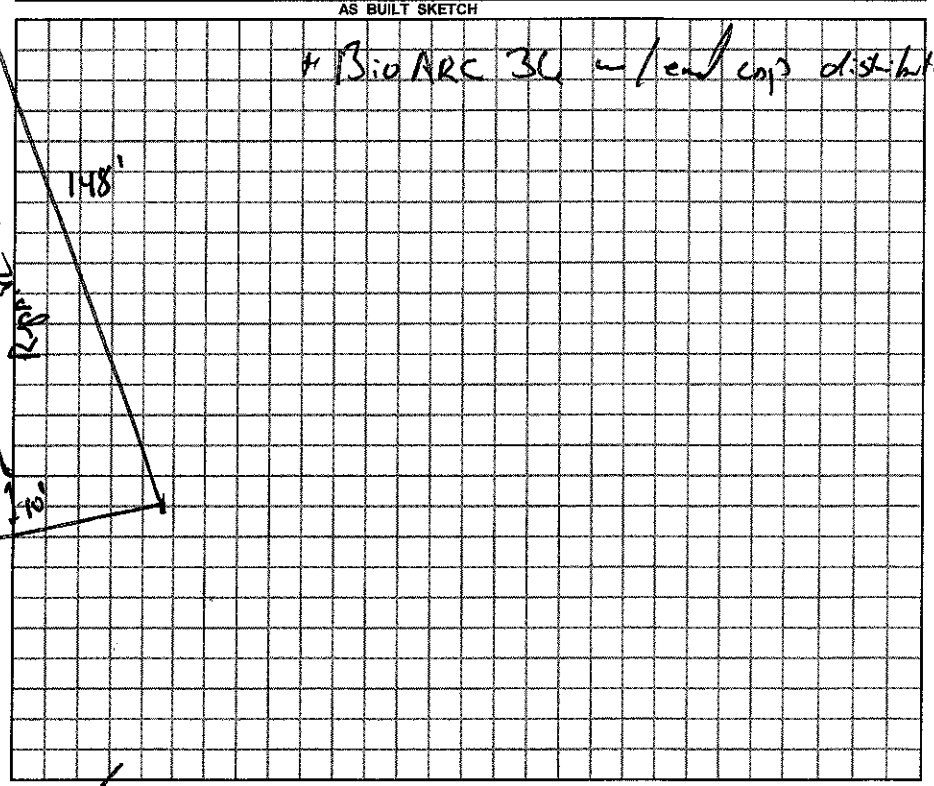

Sandalwood Cir.

Permit can be suspended or revoked if any false information is supplied toward securing the permit / any unauthorized changes are made to the site / any unauthorized changes are made in the installation of the system.

☐ *IMPROVEMENT PERMIT w / plat valid without expiration.* ☑ *IMPROVEMENT PERMIT w / site plan valid for 60 mos.* ☑ *AUTHORIZATION TO CONSTRUCT valid for period equal to IMPROVEMENT PERMIT-not to exceed 60 mo.*

Owner / Applicant Signature: Date 10-14-2010

Improvement Permit by: , R.S. Date 12 Oct. 10

Authorization to Construct by: , R.S. Date 12 Oct. 10

YOU SHOULD CONTACT A LOCATOR SERVICE PRIOR TO ANY EXCAVATION.

Installed by: Richard Abernathy

Operation Permit by: , R.S. Date: 6 May 11

Existing System Inspected by: Date:

WHITE COPY Environmental Health YELLOW COPY (Final) Owner / Applicant PINK COPY (Initial) Owner / Applicant