IREDELL COUNTY HEALTH DEPARTMENT

STATESVILLE 704-878-5305 MOORESVILLE 704-664-5281

IMPROVEMENT PERMIT / AUTHORIZATION TO CONSTRUCT / OPERATION PERMIT / EXISTING SYSTEM INSPECTION

PERMIT # 156960 PIN # 4757-37-9369 DATE 25 June 09

OWNER or APPLICANT James Laurenson PHONE: Business Home: (704) 622-4442

OWNER or APPLICANT ADDRESS 3243 Stone Mill Path Sherrills Ford

LOCATION / DIRECTIONS H-16 N TL Maple Circle TL Raven Crest TL Wildeman ON Left.

SUBDIVISION The Highlands @ Maple Creek BLOCK / SECTION LOT # 20 LOT AREA 0.59ac. DESIGN FLOW 360gpd L.T.A.R. 0.3gpd/ft²

Septic Tank 1000 Gallons: STB 312 Date 5-4-10

Pump Tank Gallons: PT Date

Pump Make Model Serial #

Nitrification Field No Fields 1 No Lines 4 Linear Feet 300

Trench Width 36" Max. Trench Bottom Depth 36" Gravel Depth

☑ New System ☐ Repair ☐ Expansion System Type I II III IV V VI

System Description: 25% Reduction

Repair System Description: 50% Reduction - Pump

Maintenance Agreement Required ☐ YES ☑ NO

☑ GRAVITY ☐ PRESSURE

☑ Residence No. Bedrooms 3

☐ Business No. Persons

☐ Other No. Employees

☐ Slab ☑ Crawl Space

☐ Basement w/plumbing ☐ Basement w/o plumbing

Water Supply: ☐ Private ☑ Public ☐ Community


Comments / Conditions: Follow contour / Mower setback requirements. TANK MAY BE LOCATED ON RIGHT SIDE (SOUTH WEST SIDE) OF HOUSE

Comments / Conditions: Tuff-Tite Filter for

INITIAL SITE SKETCH

Please see Attached site sketch.

AS BUILT SKETCH

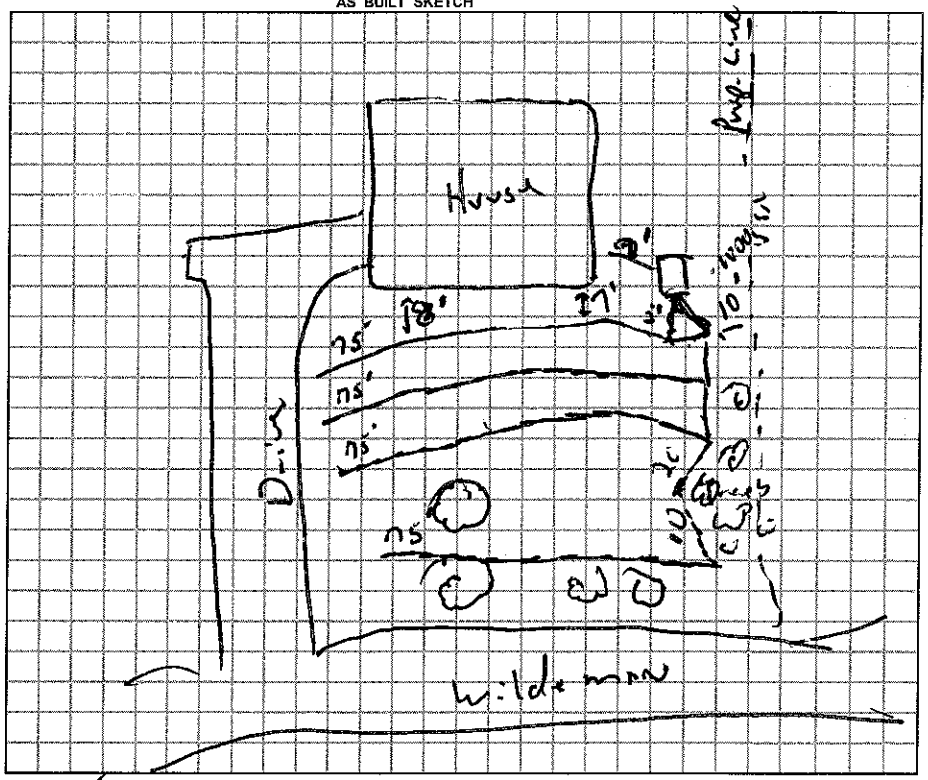

Permit can be suspended or revoked if any false information is supplied toward securing the permit / any unauthorized changes are made to the site / any unauthorized changes are made in the installation of the system.

☐ *IMPROVEMENT PERMIT w / plat valid without expiration.* ☑ *IMPROVEMENT PERMIT w / site plan valid for 60 mos.* ☑ *AUTHORIZATION TO CONSTRUCT valid for period equal to IMPROVEMENT PERMIT-not to exceed 60 mo.*

Owner / Applicant Signature: James Laurenson Date 6-25-09

Improvement Permit by: Jim Haynes, R.S. Date 25 June 09

Authorization to Construct by: Date JUNE 8, 10

Installed by: S & S Grading

Operation Permit by: Jim Haynes, R.S. Date: 29 June 10

Existing System Inspected by: Date:

YOU SHOULD CONTACT A LOCATOR SERVICE PRIOR TO ANY EXCAVATION.

WHITE COPY Environmental Health YELLOW COPY (Final) Owner / Applicant PINK COPY (Initial) Owner / Applicant