IREDELL COUNTY HEALTH DEPARTMENT

STATESVILLE 704-878-5305 (C1) MOORESVILLE

IMPROVEMENT PERMIT / AUTHORIZATION TO CONSTRUCT / OPERATION PERMIT / EXISTING S

PERMIT# 146916 PIN# 4757-38-5188

OWNER OR APPLICANT JAMES E. KEITH, JR PHONE: Business Home 70

ADDRESS 10115 EAST BROAD STREET STATESVILLE, NC 28677

LOCATION US 21 N, TL MAPLE CREEK DR TL RAVENCREST DRIVE, LOT AT END ON RIGH

SUBDIVISION HIGHWAY 21 @ MAPLE CREEK BLOCK SECTION LOT 8 LOT AREA 3.43 ACRES SITE CLASS PS DESIGN FLOW 480

Septic Tank: 1000 Gallons; STB 760 Date 5-3-08

Pump Tank: Gallons; PT Date

Pump Make: Model Serial No.

Nitrification Field: No Fields 1 Square Feet ER.TO 1600 Linear Feet 400

No Lines FOUR Trench Width 36" Max Trench Bottom Depth 30 Gravel Depth N/A

☑ New System ☐ Repair ☐ Expansion System Type: I II III IV V VI

System Description: 25% REDUCTION, GRAVITY

Repair System Description: 25% REDUCTION, GRAVITY

Maintenance Agreement Required: ☐ Yes ☑ No


☑ Gravity ☐ Pressure ☐ Slab ☐ Crawl Space ☑ Basemen

☑ House/Mod. Home ☐ Mobile Home ☐ Business ☐ Other


Comments/Conditions: ① INSTALL 25% REDUCTION SYSTEM ON CONTOUR AS SHOWN. ② INSTALL LINES NO DEEPER THAN 30"

Comments/Conditions: SEPTIC TANK WIS INSTALLED USING RED

INITIAL SITE SKETCH

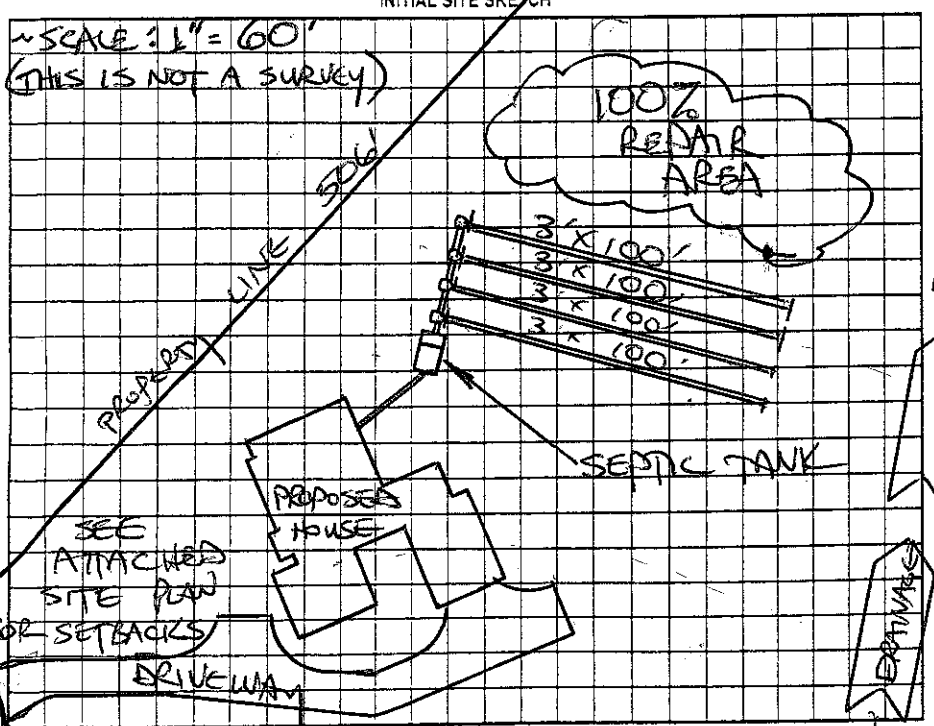

AS BUILT SKETCH

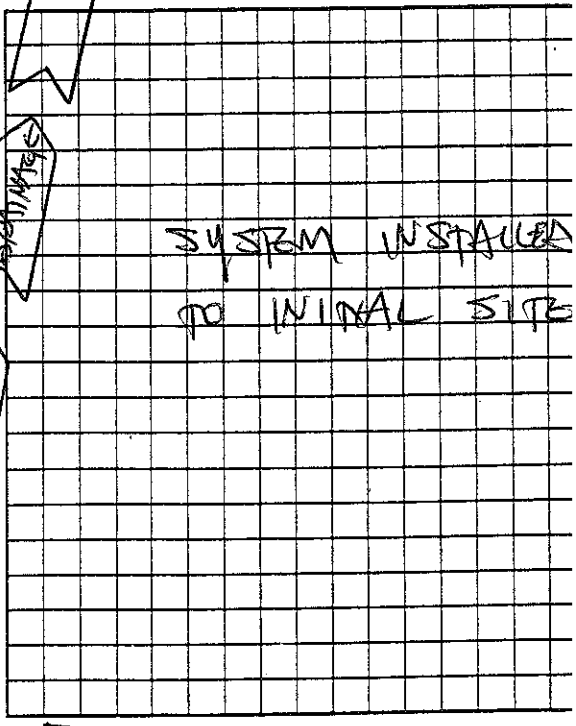

Permit can be suspended or revoked if any false information is supplied toward securing the permit/any unauthorized changes are made to the site/any unauthorized changes are made in th

Permit with plat valid without expiration ☐ Improvement Permit with site plan valid for sixty months ☑ Authorization to Construct is valid for a period equal to that of Improve

Signed: [signature] date 12-13-07 Installed by: A-1 BACKHOE

Improvement Permit by: STEVE HEDRICK date 12-13-2007 Operation Permit by: STEVE HEDRICK

Authorization to Construct by: STEVE HEDRICK date 12-13-2007 Existing System Inspection by:

HEALTH DEPT. COPY: WHITE OWNER COPY (FINAL): YELLOW OWNER COPY (INITIAL): PINK

(CK)

IREDELL COUNTY HEALTH DEPARTMENT

STATESVILLE 704-878-5305 (C1) MOORESVILLE 704-664-5281

IMPROVEMENT PERMIT / AUTHORIZATION TO CONSTRUCT / OPERATION PERMIT / EXISTING SYSTEM INSPECTION

PERMIT# 146916 PIN# 4757-38-5188 DATE 12-13-2007

OWNER OR APPLICANT JAMES E. KEITH, JR PHONE: Business Home 704-871-1041

ADDRESS 10115 EAST BROAD STREET, STATESVILLE, NC 28677

LOCATION 45 21 N, TL MAPLE CREEK DR, TL RAVENCREST DRIVE, LOT AT END ON RIGHT

SUBDIVISION HIGHLANDS @ MAPLE CREEK SECTION LOT 8 LOT AREA 3.43 ACRES SITE CLASS. PS DESIGN FLOW 480 L.T.A.R. 0.30 SPA/FT²

Septic Tank: 1000 Gallons; STB 760 Date 5-3-08
Pump Tank: Gallons; PT Date
Pump Make: Model EZ-1.0 Serial No.
Nitrification Field: No Fields 1 Square Feet 1600 Linear Feet 400
No Lines FOUR Trench Width 36" Max Trench Bottom Depth 30"

☑ New System ☐ Repair ☐ Expansion System Type: I II III IV V VI
System Description: 25% REDUCTION, GRAVITY
Repair System Description: 25% REDUCTION, GRAVITY
Maintenance Agreement Required: ☐ Yes ☑ No
Gravel Depth N/A ☑ Gravity ☐ Pressure


☑ House/Mod. Home ☐ Mobile Home ☐ Business ☐ Other
No. Bedrooms 4 No. Persons No. Employees
☐ Slab ☐ Crawl Space ☑ Basement w/plumbing ☐ Basement wo/plumbing

Water Supply: ☐ Individual ☑ Public ☐ Community


Comments:/Conditions: ① INSTALL 25% REDUCTION SYSTEM ON CONTOUR AS SHOWN. ② INSTALL LINES NO DEEPER THAN 30"

Comments:/Conditions: SEPTIC TANK WITH MARKER INSTALLED USING RED "PolyLok" FILTER

INITIAL SITE SKETCH

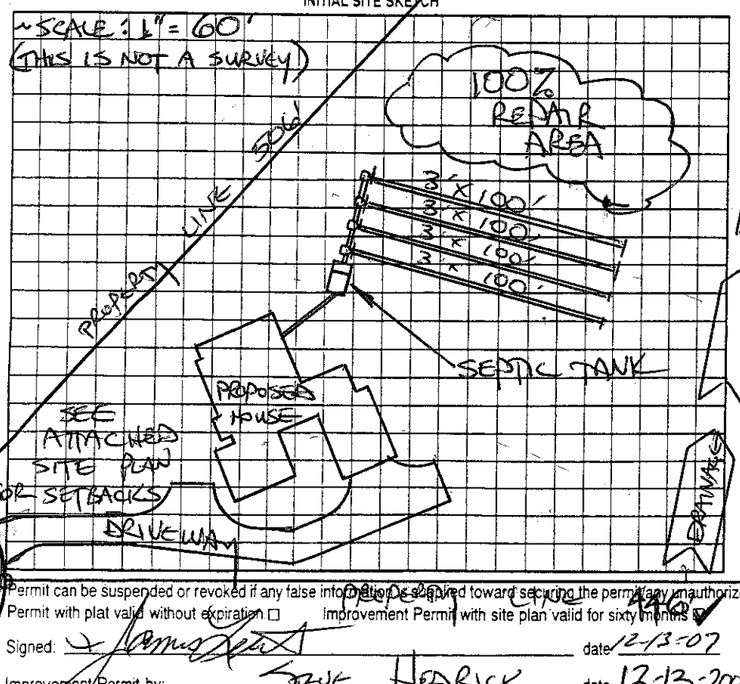

AS BUILT SKETCH

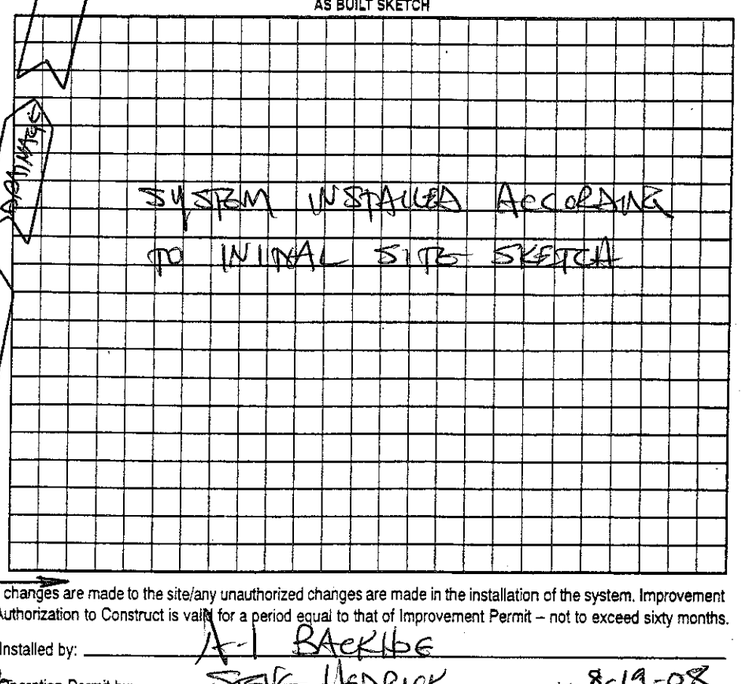

Permit can be suspended or revoked if any false information is received toward securing the permit/any unauthorized changes are made to the site/any unauthorized changes are made in the installation of the system. Improvement Permit with plat valid without expiration ☐ Improvement Permit with site plan valid for sixty months ☑ Authorization to Construct is valid for a period equal to that of Improvement Permit – not to exceed sixty months.

Signed: [signature] date 12-13-07 Installed by: A-1 BACKHOE

Improvement Permit by: STEVE HENDRICK date 12-13-2007 Operation Permit by: STEVE HENDRICK date 8-19-08

Authorization to Construct by: STEVE HENDRICK date 12-13-2007 Existing System Inspection by: date

HEALTH DEPT. COPY: WHITE OWNER COPY (FINAL): YELLOW OWNER COPY (INITIAL): PINK