IREDELL COUNTY HEALTH DEPARTMENT

STATESVILLE 704-878-5305 MOORESVILLE 704-664-5281

IMPROVEMENT PERMIT / AUTHORIZATION TO CONSTRUCT / OPERATION PERMIT / EXISTING SYSTEM INSPECTION

PERMIT # 161516 PIN # 4757-46-0786 DATE 30 June 10

OWNER or APPLICANT Jeremy + Cheryl Bridges PHONE: Business (704) 872-0223 Home: (704) 450-8495

OWNER or APPLICANT ADDRESS Phil Smith Builders 582 New Salem Rd Statesville, NC.

LOCATION / DIRECTIONS Hwy 21 N TL Maple Creek TL Rosewood TL Sandalwood TL Lone Poplar.

SUBDIVISION The Highlands @ Maple Creek BLOCK / SECTION LOT # 32 LOT AREA 1 Ac. DESIGN FLOW 480 gpd L.T.A.R. 0.35/FT²/d

Septic Tank 1000 Gallons: STB Date

Pump Tank Gallons: P T Date

Pump Make Model Serial #

Nitrification Field No Fields 1 No Lines 5 Linear Feet 400

Trench Width 36" Max. Trench Bottom Depth 36" Gravel Depth NA

☑ New System ☐ Repair ☐ Expansion System Type I II III IV V VI

System Description: 25% Reduction System

Repair System Description: 50% Reduction w/LPP Distrib

Maintenance Agreement Required ☐ YES ☑ NO

☑ GRAVITY ☐ PRESSURE

☑ Residence No. Bedrooms 4

☐ Business No. Persons

☐ Other No. Employees


☐ Slab ☐ Crawl Space

☐ Basement w/plumbing ☑ Basement w/o plumbing

Water Supply: ☐ Private ☑ Public ☐ Community


Comments / Conditions

INITIAL SITE SKETCH

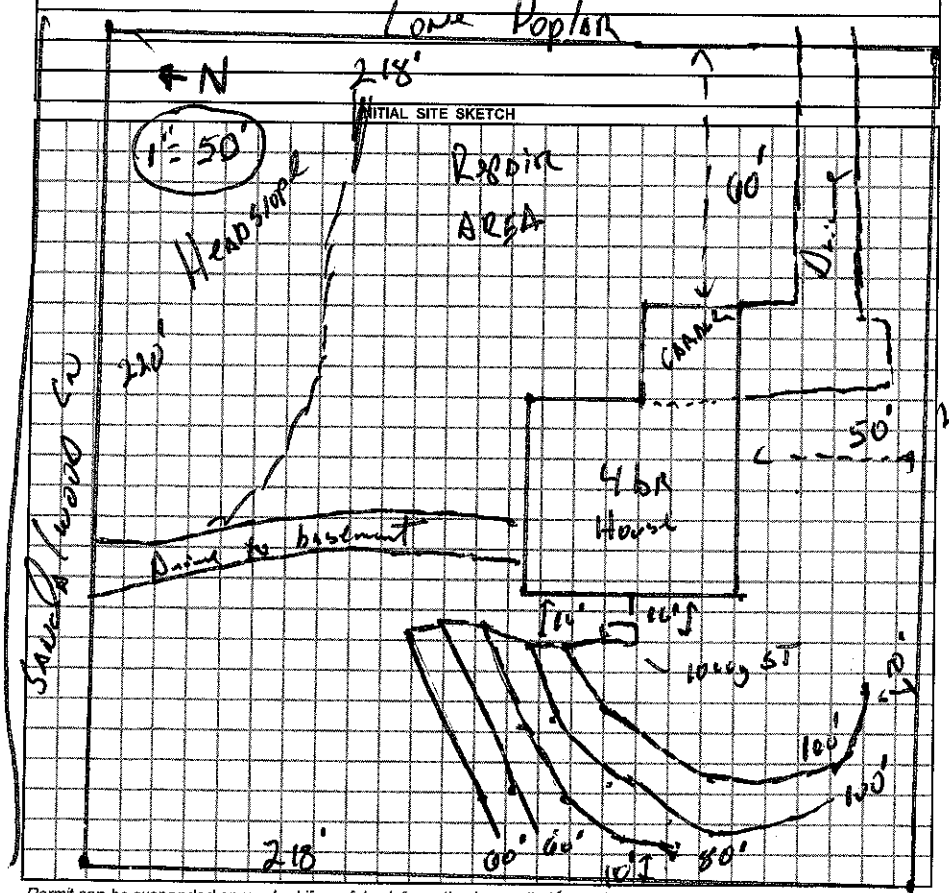

Comments / Conditions

AS BUILT SKETCH

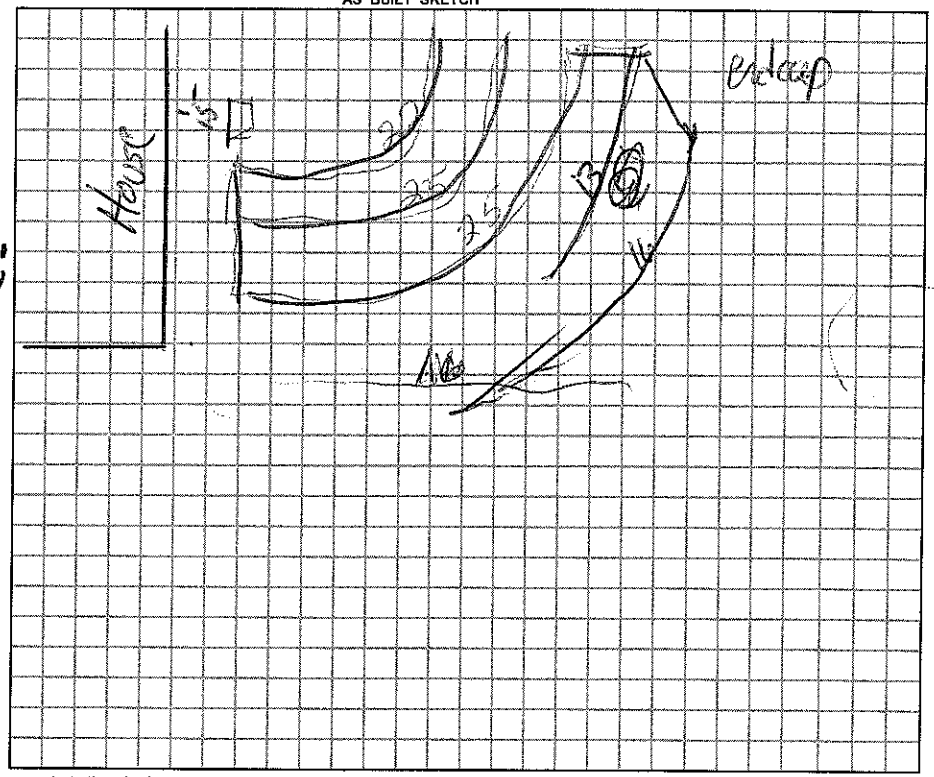

Permit can be suspended or revoked if any false information is supplied toward securing the permit / any unauthorized changes are made to the site / any unauthorized changes are made in the installation of the system.

☐ *IMPROVEMENT PERMIT w / plat valid without expiration.* ☑ *IMPROVEMENT PERMIT w / site plan valid for 60 mos.* ☑ *AUTHORIZATION TO CONSTRUCT valid for period equal to IMPROVEMENT PERMIT-not to exceed 60 mo.*

Owner / Applicant Signature: Date 1 July 10

Improvement Permit by: R.S. Date 30 June 10

Authorization to Construct by: R.S. Date 30 June 10

YOU SHOULD CONTACT A LOCATOR SERVICE PRIOR TO ANY EXCAVATION.

Installed by: Tommy Frye

Operation Permit by: Date: 7-5-11

Existing System Inspected by: Date:

WHITE COPY Environmental Health YELLOW COPY (Final) Owner / Applicant PINK COPY (Initial) Owner / Applicant