Mike & Judy Lafone

IREDELL COUNTY HEALTH DEPARTMENT

STATESVILLE 704-878-5305 (or) MOORESVILLE 704-664-5281

IMPROVEMENT PERMIT / AUTHORIZATION TO CONSTRUCT / OPERATION PERMIT / EXISTING SYSTEM INSPECTION

PERMIT # 154739 PIN # 4757464817 DATE 2/25/09

OWNER or APPLICANT Horne Building, Inc. PHONE: Business 704-878-2224 Home:

OWNER or APPLICANT ADDRESS Horne Building / 229 Cedar Lake Drive / Statesville, NC 28625

LOCATION / DIRECTIONS 21N, (L) on Maple Creek, (L) on Ravencrest, (L) on Sandalwood, lot at corner of Lane Poplar

SUBDIVISION The Highlands @ Maple Creek BLOCK / SECTION LOT # 39 LOT AREA 1.7485 DESIGN FLOW 360 L.T.A.R. .3

Septic Tank 1000 Gallons: STB 760 Date 4-16-09

Pump Tank 1000 Gallons: P.T 375 Date 4-23-09

Pump Make Zoeller Model N152 Serial # 152-0082

Nitrification Field No Fields 1 No Lines 4 Linear Feet 300

Trench Width 36" Max. Trench Bottom Depth 20" Gravel Depth n/a

☒ New System ☐ Repair ☐ Expansion System Type I II (III) IV V VI

System Description: 25% Reduction Pump

Repair System Description: 25% Reduction Pump

Maintenance Agreement Required ☐ YES ☒ NO

☒ GRAVITY ☒ PRESSURE

☒ Residence No. Bedrooms 3 ☐ Business No. Persons ☐ Other No. Employees ☐ Slab ☐ Crawl Space ☒ Basement w/plumbing ☐ Basement w/o plumbing

Water Supply: ☐ Private ☒ Public ☐ Community

Comments / Conditions


Lynx Plus Pump 7-28-09 KW

Comments / Conditions

Red Jetta

Septic Made

INITIAL SITE SKETCH

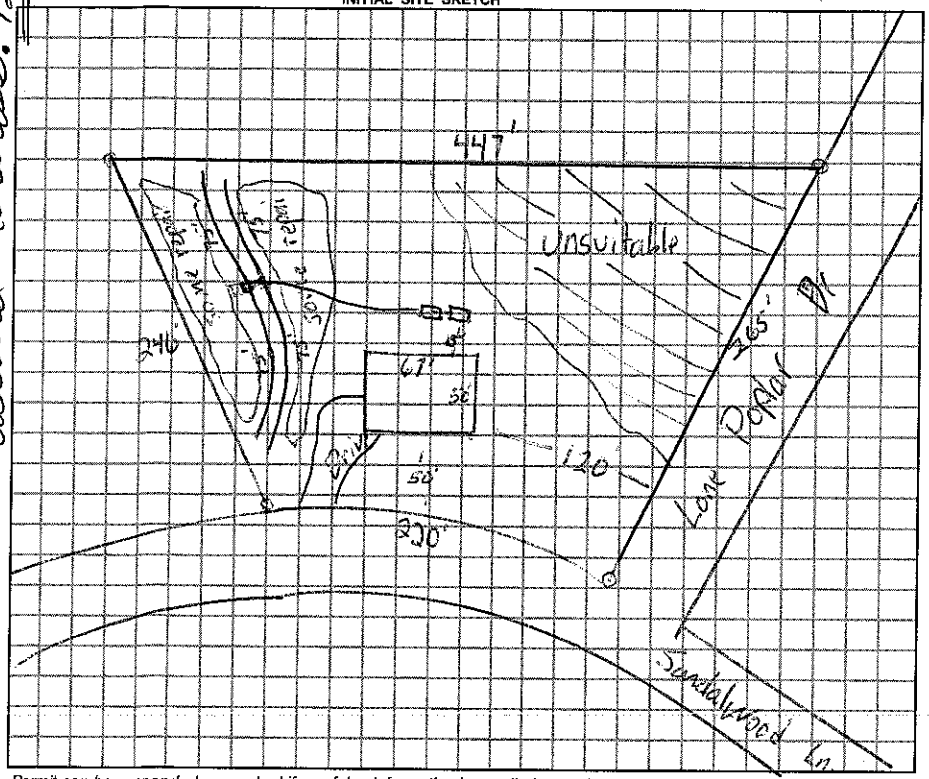

AS BUILT SKETCH

Actual address: 121 Sandalwood Ln.

Permit can be suspended or revoked if any false information is supplied toward securing the permit / any unauthorized changes are made to the site / any unauthorized changes are made in the installation of the system.

☒ *IMPROVEMENT PERMIT w / plat valid without expiration.* ☒ *IMPROVEMENT PERMIT w / site plan valid for 60 mos.* ☐ *AUTHORIZATION TO CONSTRUCT valid for period equal to IMPROVEMENT PERMIT-not to exceed 60 mo.*

Owner / Applicant Signature: Carolyn B Horne Date 3-16-09

Improvement Permit by: Date 2-26-09

Authorization to Construct by: Date 2-26-09

YOU SHOULD CONTACT A LOCATOR SERVICE PRIOR TO ANY EXCAVATION.

Installed by: Tommy Cothren

Operation Permit by: Date: 10-9-09

Existing System Inspected by: Date:

WHITE COPY Environmental Health YELLOW COPY (Final) Owner / Applicant PINK COPY (Initial) Owner / Applicant