IREDELL COUNTY HEALTH DEPARTMENT (ad) STATESVILLE 704-878-5305 (CI) MOORESVILLE 704-664-5281

IMPROVEMENT PERMIT / AUTHORIZATION TO CONSTRUCT / OPERATION PERMIT / EXISTING SYSTEM INSPECTION

PERMIT # 153412 PIN # 4757-46-7461 6359 DATE 12-19-08 LOCK #

OWNER or APPLICANT GARY & SUSAN SLEEMAN PHONE: Business 704-483-1457 Susan Home: 7049782890 | 704-883 6358 Cell

OWNER or APPLICANT ADDRESS County Tyme NC LLC PO BOX 1109 DENVER NC 28037

LOCATION / DIRECTIONS 21 N (L) MAPLE CREEK (L) RAVEN CREST (L) SAWAR WOOD (L) Lone POPLAR AT END


SUBDIVISION Maple Creek (Highlands @ Maple Creek) BLOCK / SECTION LOT # 35/36 LOT AREA 5.7402 DESIGN FLOW 480 L.T.A.R. .3

Septic Tank 1000	Gallons: STB 1012	Date 4-18-08	☒ New System ☐ Repair ☐ Expansion System	Type I II (III) IV V VI	☒ Residence	No. Bedrooms 4	Water Supply
Pump Tank	Gallons: P T	Date	System Description: GRAVITY 25% REDUCTION		☐ Business	No. Persons	☐ Private
Pump Make	Model	Serial #	Repair System Description: SAME		☐ Other	No. Employees	☒ Public
Nitrification Field No Fields 1	No Lines 3	Linear Feet 400'	Maintenance Agreement Required ☐ YES ☒ NO		☐ Slab	☐ Crawl Space	☐ Community
Trench Width 36"	Max. Trench Bottom Depth 36"	Gravel Depth N/A	☒ GRAVITY ☐ PRESSURE		☒ Basement w/plumbing	☐ Basement w/o plumbing	


Comments / Conditions (1) MET BUILDER / OWNER & GRADER. 54' FROM BACK OF HOME IS ADEQUATE FOR FIRST LINE WITH BASEMENT TO DAYLIGHT & 1/8" FALL PER 1 FOOT. (2) SYSTEM & HOUSE IS FLAGGED. (3) INSTALL LINES ON CONTOURS &

Comments / Conditions MAINTAIN SETBACKS. (4) RAKE SIDEWALLS & LIME TRENCH SIDEWALLS DUE TO MICA FLAKES IN SOIL. (5) GRADER / OWNER REQUESTS 25% REDUCTION SYSTEM. (6) Sized system for future 4th BEDROOM TO BE ADDED IN

INITIAL SITE SKETCH

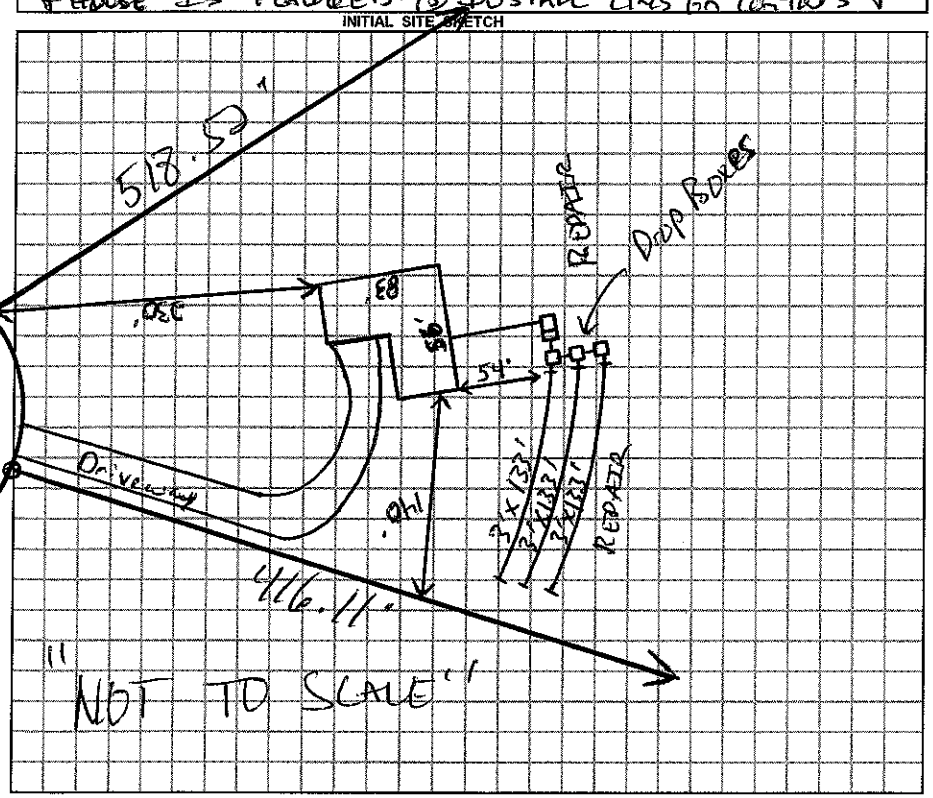

AS BUILT SKETCH

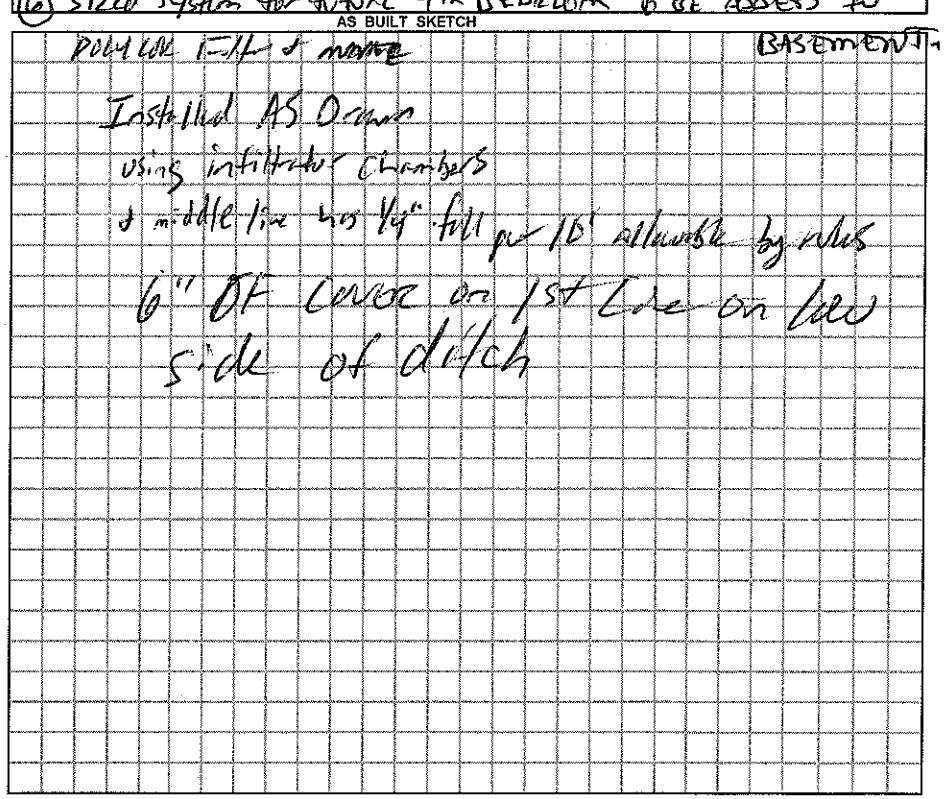

Permit can be suspended or revoked if any false information is supplied toward securing the permit / any unauthorized changes are made to the site / any unauthorized changes are made in the installation of the system.

☐ *IMPROVEMENT PERMIT w / plat valid without expiration.* ☒ *IMPROVEMENT PERMIT w / site plan valid for 60 mos.* ☐ *AUTHORIZATION TO CONSTRUCT valid for period equal to IMPROVEMENT PERMIT-not to exceed 60 mo.*

Owner / Applicant Signature: Susan Sleeman Date 12-19-08

Improvement Permit by: Date 12-19-08

Authorization to Construct by: Date 12-19-08

Installed by: Tommy Frye

Operation Permit by: Date: 11-6-09

Existing System Inspected by: Date:

YOU SHOULD CONTACT A LOCATOR SERVICE PRIOR TO ANY EXCAVATION.

WHITE COPY Environmental Health YELLOW COPY (Final) Owner / Applicant PINK COPY (Initial) Owner / Applicant