Stephen + Lisa Stewart — Detached Garage addn 3/09

IREDELL COUNTY HEALTH DEPARTMENT

STATESVILLE 704-878-5305 (ar) (ao) MOORESVILLE 704-664-5281

IMPROVEMENT PERMIT / AUTHORIZATION TO CONSTRUCT / OPERATION PERMIT / EXISTING SYSTEM INSPECTION

PERMIT# 15|709 PIN# 4757466695 DATE 8-14-08

OWNER OR APPLICANT Samuel G. Scott Contracting Co, Inc PHONE: Business 704 873 1391 Home

ADDRESS 2278 S. Chipley Ford

LOCATION 19 Lone Poplar Dr. L 21 N, (L) on Maple Creek, (L) on Ravencrest, (L) on Sandalwood, (L) on Lone Poplar

SUBDIVISION Highlands BLOCK / SECTION LOT 37 LOT AREA 1.7365 Ac. SITE CLASS. 15 DESIGN FLOW 360 L.T.A.R. .03

Septic Tank: 1000 Gallons; STB 1012 Date 2-25-09
Pump Tank: Gallons; PT Date
Pump Make: Model Serial No.
Nitrification Field: No Fields 1 Square Feet 1,200 Linear Feet 300
No Lines Trench Width 36 Max Trench Bottom Depth 36

■ New System ☐ Repair ☐ Expansion System Type: I II III IV V VI
System Description: 25% Reduction Gravity
Repair System Description: 25% Reduction Pressure Pump
Maintenance Agreement Required: ☐ Yes ■ No

■ House/Mod. Home No. Bedrooms 3
☐ Mobile Home No. Persons
☐ Business No. Employees
☐ Other


Water Supply: ☐ Individual ■ Public ☐ Community

Gravel Depth n/a ■ Gravity ☐ Pressure ☐ Slab ■ Crawl Space ☐ Basement w/plumbing ☐ Basement wo/plumbing


Comments/Conditions:

Comments/Conditions:

INITIAL SITE SKETCH

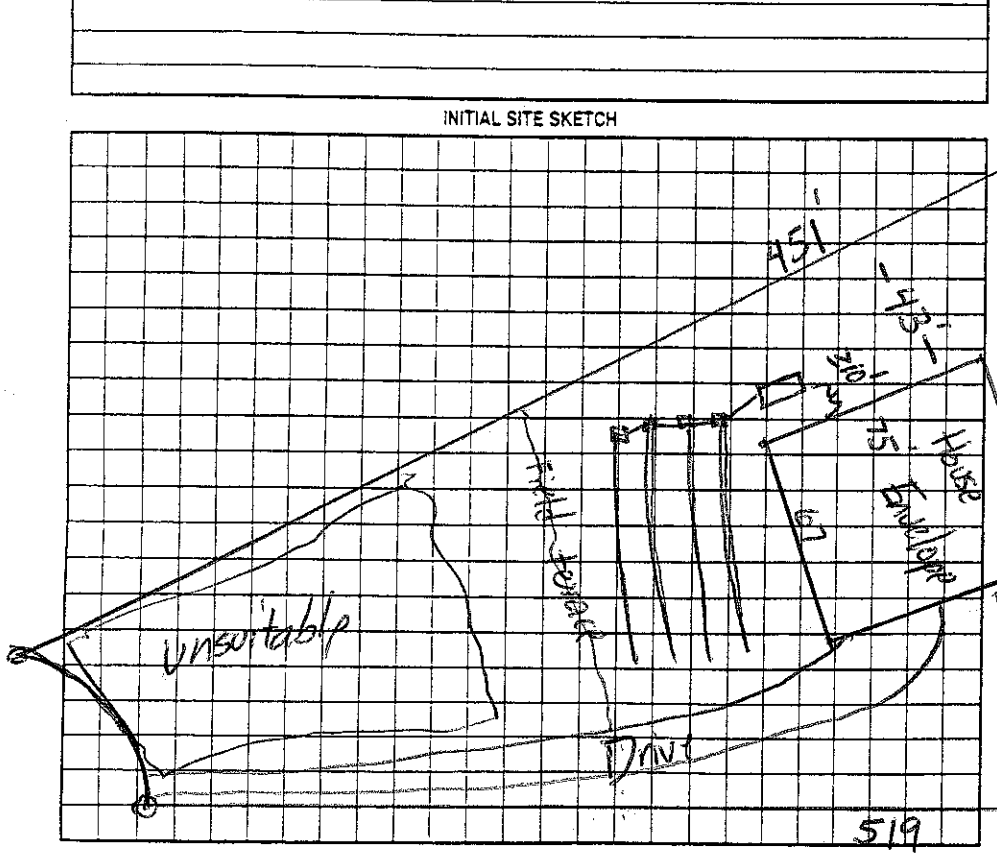

AS BUILT SKETCH

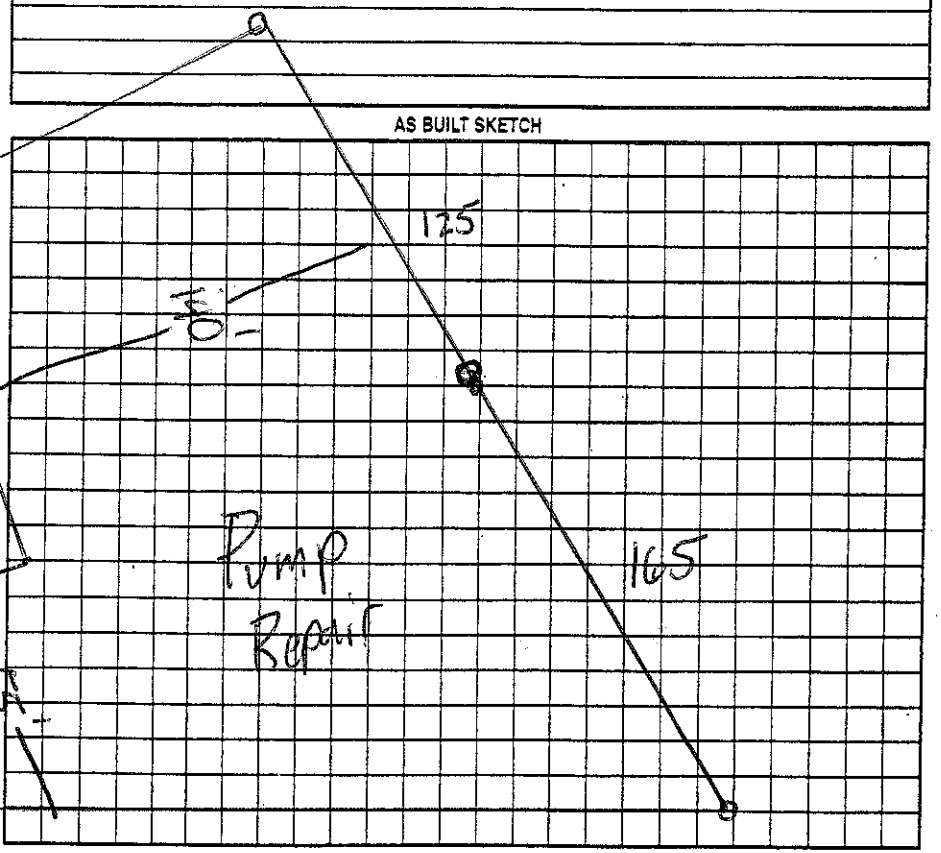

Permit can be suspended or revoked if any false information is supplied toward securing the permit/any unauthorized changes are made to the site/any unauthorized changes are made in the installation of the system. Improvement Permit with plat valid without expiration ☐ Improvement Permit with site plan valid for sixty months ■ Authorization to Construct is valid for a period equal to that of Improvement Permit – not to exceed sixty months.

Signed: David Scott date 8-18-08

Improvement Permit by: James Gillespie date 8-14-08

Authorization to Construct by: James Gillespie date 8-14-08

Installed by: Yount Grading

Operation Permit by: James Gillespie date 2-25-09

Existing System Inspection by: date

HEALTH DEPT. COPY: WHITE OWNER COPY (FINAL): YELLOW OWNER COPY (INITIAL): PINK