Stephen + Lisa Stewart

Detached Garage Addn 3/09

IREDELL COUNTY HEALTH DEPARTMENT

STATESVILLE 704-878-5305 (ao) (po) MOORESVILLE 704-664-5281

IMPROVEMENT PERMIT / AUTHORIZATION TO CONSTRUCT / OPERATION PERMIT / EXISTING SYSTEM INSPECTION

PERMIT# 151709 PIN# 4757466695 DATE 8-14-08

OWNER OR APPLICANT Samuel G. Scott Contracting Co, Inc PHONE: Business 704 873 1391 Home

ADDRESS 2228 S. Chipley Ford

LOCATION 119 Lone Poplar Dr. L 21N, (L) on Maple Creek, (L) on Ravencrest, (L) on Sirdalwood, (L) on Lone Poplar

SUBDIVISION Highlands BLOCK / SECTION LOT 37 LOT AREA 1.7365 Ac SITE CLASS 1S DESIGN FLOW 360 L.T.A.R. .3

Septic Tank: 1000 Gallons: STB 1012 Date 2-25-08

Pump Tank: Gallons: PT Date

Pump Make: Model Serial No.

Nitrification Field: No Fields 1 Square Feet 1,200 Linear Feet 300

No Lines Trench Width 36 Max Trench Bottom Depth 36

☒ New System ☐ Repair ☐ Expansion System Type: I II III IV V VI

System Description: 25% Reduction Gravity

Repair System Description: 25% Reduction Gravity to Pump

Maintenance Agreement Required: ☐ Yes ☒ No

☒ House/Mod. Home ☐ Mobile Home ☐ Business ☐ Other

No. Bedrooms 3 No. Persons No. Employees


Water Supply: ☐ Individual ☒ Public ☐ Community

Gravel Depth n/a ☒ Gravity ☐ Pressure ☐ Slab ☒ Crawl Space ☐ Basement w/plumbing ☐ Basement wo/plumbing


Comments:/Conditions:

Comments:/Conditions:

INITIAL SITE SKETCH

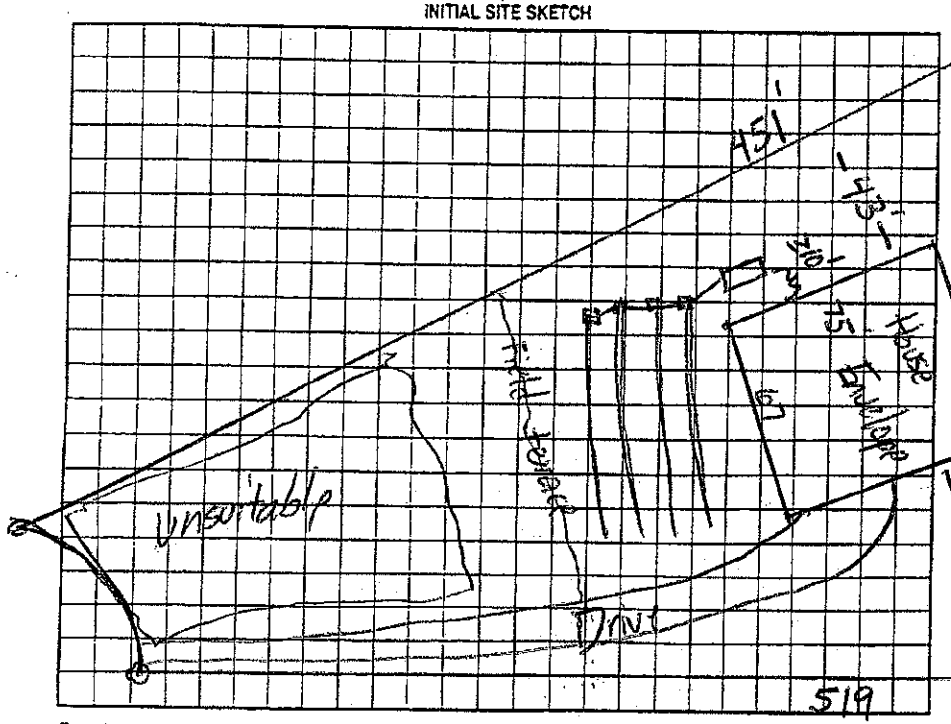

AS BUILT SKETCH

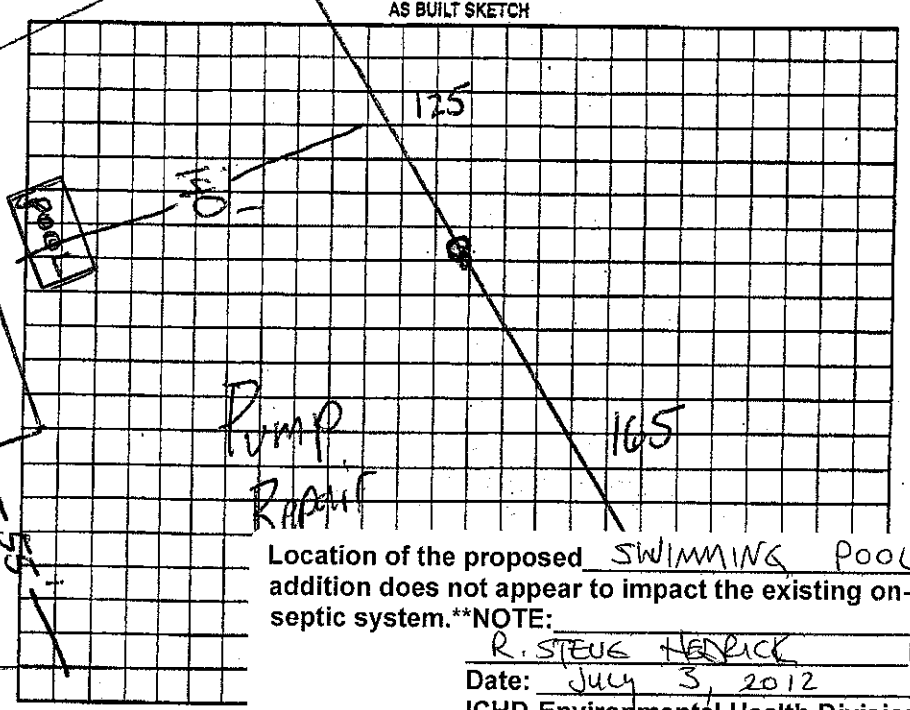

Location of the proposed SWIMMING POOL addition does not appear to impact the existing on-site septic system.NOTE:**

R. STEVE HENDRICK REHS

Date: July 3, 2012

ICHD-Environmental Health Division

Permit can be suspended or revoked if any false information is supplied toward securing the permit/any unauthorized changes are made to the site/any unauthorized changes are made in the installation of the system. Improvement Permit with plat valid without expiration ☐ Improvement Permit with site plan valid for sixty months ☒ Authorization to Construct is valid for a period equal to that of Improvement Permit – not to exceed sixty months.

Signed: date 8-18-08

Improvement Permit by: date 8-14-08

Authorization to Construct by: date 8-14-08

Installed by: Young Grading

Operation Permit by: date 2-25-09

Existing System Inspection by: date

HEALTH DEPT. COPY: WHITE OWNER COPY (FINAL): YELLOW OWNER COPY (INITIAL): PINK