IREDELL COUNTY HEALTH DEPARTMENT

STATESVILLE 704-878-5305 MOORESVILLE 704-664-5281

IMPROVEMENT PERMIT / AUTHORIZATION TO CONSTRUCT / OPERATION PERMIT / EXISTING SYSTEM INSPECTION

PERMIT# 094347 PIN# 4757 47 2480 PT DATE 02/17/01

OWNER OR CONTRACTOR WAYNE HOMES PHONE: Business 704-799-8127 Home

ADDRESS 139 SAND REED DR, MOORESVILLE, NC 28117

LOCATION 21 N, (R) on MAPLE CREEK DR, ON LEFT

SUBDIVISION MAPLE CREEK BLOCK / SECTION LOT 41 LOT AREA .83 SITE CLASS PS DESIGN FLOW 360 L.T.A.R. .35

Septic Tank: 1000 Gallons; STB 312 Date 5-17-01
Pump Tank: Gallons; PT Date
Pump Make: Model Serial No.
Nitrification Field: No Fields 1 Square Feet 1035 Linear Feet 345
No Lines THREE Trench Width 36" Max Trench Bottom Depth 36" Gravel Depth 12"

[X] New System [ ] Repair System Type: I (II) III, IV, V, VI
System Description: CONV GRAV
Repair System Description: PUMP PANEL
Maintenance Agreement Required: [ ] Yes [X] No
[ ] Slab [X] Crawl Space [ ] Basement w/plumbing [ ] Basement wo/plumbing


[X] House/Mod. Home No. Bedrooms 3
[ ] Mobile Home No. Bathrooms 2
[ ] Business No. Employees
[ ] Other

Water Supply: [ ] Individual [X] Public [ ] Community


Comments/Conditions: (1) INSTALL LINES ON CONTOUR (2) STAY 10' off property lines & 10' off old systems.

Comments/Conditions: SYSTEM INSTALLED AS SHOWN WITH POLYLOK FILTER & MARKER

INITIAL SITE SKETCH

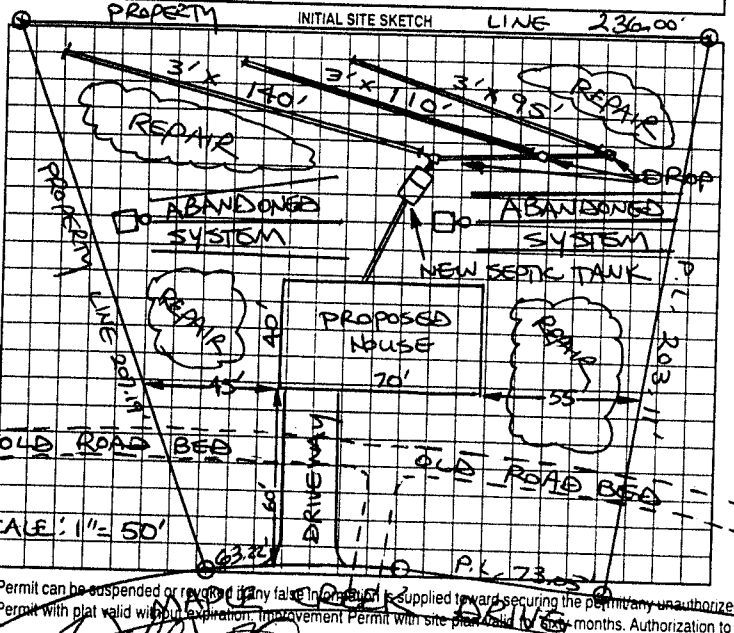

AS BUILT SKETCH

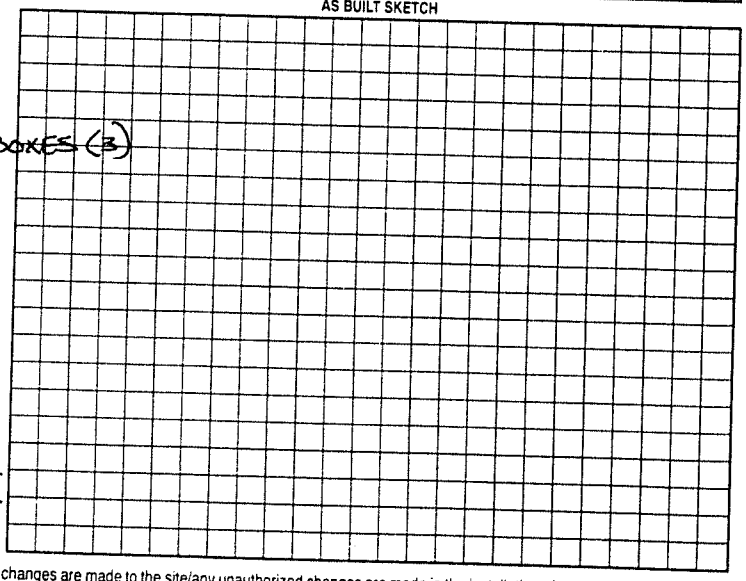

Permit can be suspended or revoked if any false information is supplied toward securing the permit, any unauthorized changes are made to the site/any unauthorized changes are made in the installation of the system. Improvement Permit with plat valid without expiration. Improvement Permit with site plan valid for sixty months. Authorization to Construct is valid for a period equal to that of Improvement Permit – not to exceed sixty months.

Signed: date

Improvement Permit by: date 02/17/01

Authorization to Construct by: date 02/17/01

Installed by: Mitchell Grading

Operation Permit by: date 6-15-01

Existing System Inspection by: date

HEALTH DEPT. COPY: WHITE OWNER COPY (FINAL): YELLOW OWNER COPY (INITIAL): PINK