IREDELL COUNTY HEALTH DEPARTMENT

STATESVILLE 704-878-5305 MOORESVILLE 704-664-5281

IMPROVEMENT PERMIT / AUTHORIZATION TO CONSTRUCT / OPERATION PERMIT / EXISTING SYSTEM INSPECTION

PERMIT # 156735 PIN # 4757471193 DATE 6/24/09

OWNER or APPLICANT Kathy Laughlin PHONE: Business 704-880-4325 Home:

OWNER or APPLICANT ADDRESS 566 Zeb Rd.

LOCATION / DIRECTIONS 21N, (L) on Maple Creek, (L) on Ravencrest, (L) on Sandalwood

SUBDIVISION Highlands on Maple Creek BLOCK / SECTION LOT # 25 LOT AREA 1.105 DESIGN FLOW 480 L.T.A.R. .3

Septic Tank 1000 Gallons: STB 1012 Date 7-12-08

Pump Tank Gallons: P T Date

Pump Make Model Serial #

Nitrification Field No Fields 1 No Lines 4 Linear Feet 400 total

Trench Width 36" Max. Trench Bottom Depth 36" Gravel Depth n/a

☒ New System ☐ Repair ☐ Expansion System Type I (II) III IV V VI

System Description: 25% Reduction

Repair System Description: 25% Reduction

Maintenance Agreement Required ☐ YES ☒ NO

☒ GRAVITY ☐ PRESSURE

☒ Residence No. Bedrooms 4

☐ Business No. Persons

☐ Other No. Employees

☐ Slab ☒ Crawl Space

☐ Basement w/plumbing ☐ Basement w/o plumbing


Water Supply: ☐ Private ☒ Public ☐ Community

Comments / Conditions


Comments / Conditions

Red Tag - Title

INITIAL SITE SKETCH

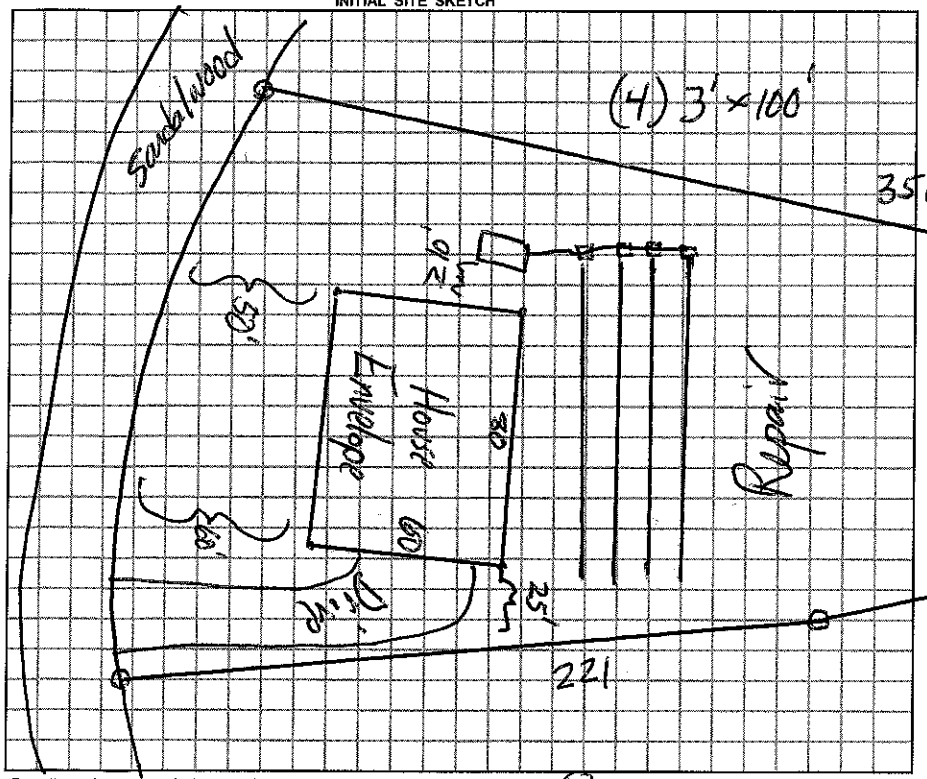

AS BUILT SKETCH

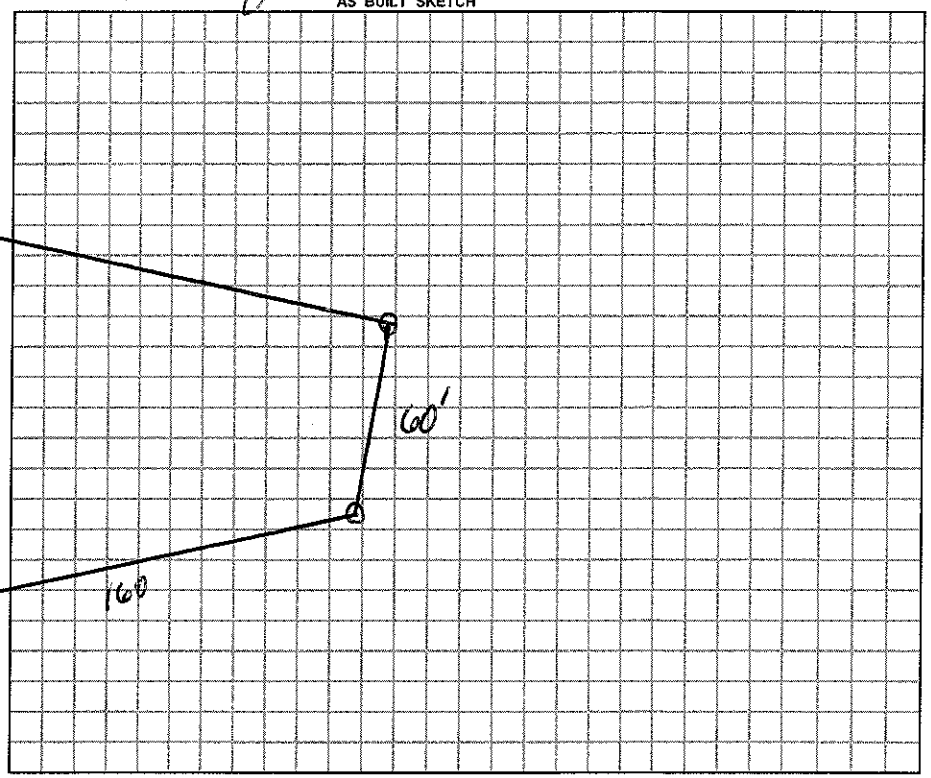

Permit can be suspended or revoked if any false information is supplied toward securing the permit / any unauthorized changes are made to the site / any unauthorized changes are made in the installation of the system.

☐ *IMPROVEMENT PERMIT w / plat valid without expiration.* ☒ *IMPROVEMENT PERMIT w / site plan valid for 60 mos.* ☐ *AUTHORIZATION TO CONSTRUCT valid for period equal to IMPROVEMENT PERMIT-not to exceed 60 mo.*

Owner / Applicant Signature: Date 6/29/2009

Improvement Permit by: Date 6-24-09

Authorization to Construct by: Date 6-24-09

Installed by: David Yount

Operation Permit by: Date: 1-10-10

Existing System Inspected by: Date:

YOU SHOULD CONTACT A LOCATOR SERVICE PRIOR TO ANY EXCAVATION.

WHITE COPY Environmental Health YELLOW COPY (Final) Owner / Applicant PINK COPY (Initial) Owner / Applicant