IREDELL COUNTY HEALTH DEPARTMENT

STATESVILLE 704-878-5305 (at) MOORESVILLE 704-664-5281

IMPROVEMENT PERMIT (at) / AUTHORIZATION TO CONSTRUCT / OPERATION PERMIT / EXISTING SYSTEM INSPECTION

PERMIT # 152897 PIN # 4757-47-2679 DATE 12-29-08

OWNER or APPLICANT Tom Palmer Homes PHONE: Business (704) 780-1448 Home:

OWNER or APPLICANT ADDRESS 125 O'Henry Avenue, Davidson, NC

LOCATION / DIRECTIONS (R) Turnersburg Hwy, (L) Maple Creek, (L) Ravencrest, house on right

SUBDIVISION Highlands at Maple Creek BLOCK / SECTION LOT # 3 LOT AREA 1.24 acres DESIGN FLOW 360 gpd L.T.A.R. .3

Septic Tank 1000 Gallons: STB 760 Date 10-1-09

Pump Tank Gallons: PT Date

Pump Make Model Serial #

Nitrification Field No Fields 1 No Lines 3 Linear Feet 300

Trench Width 3' Max. Trench Bottom Depth 36" Gravel Depth N/A

☑ New System ☐ Repair ☐ Expansion System Type I II (III) IV V VI

System Description: 25% red. gravity

Repair System Description: 25% red. gravity

Maintenance Agreement Required ☐ YES ☑ NO

☑ GRAVITY ☐ PRESSURE

☑ Residence No. Bedrooms 3

☐ Business No. Persons

☐ Other No. Employees

☐ Slab ☑ Crawl Space


☐ Basement w/plumbing ☐ Basement w/o plumbing

Water Supply: ☐ Private ☑ Public ☐ Community


Comments / Conditions: * maintain all setbacks, system shall be installed on contour

Comments / Conditions: Red Filter

INITIAL SITE SKETCH

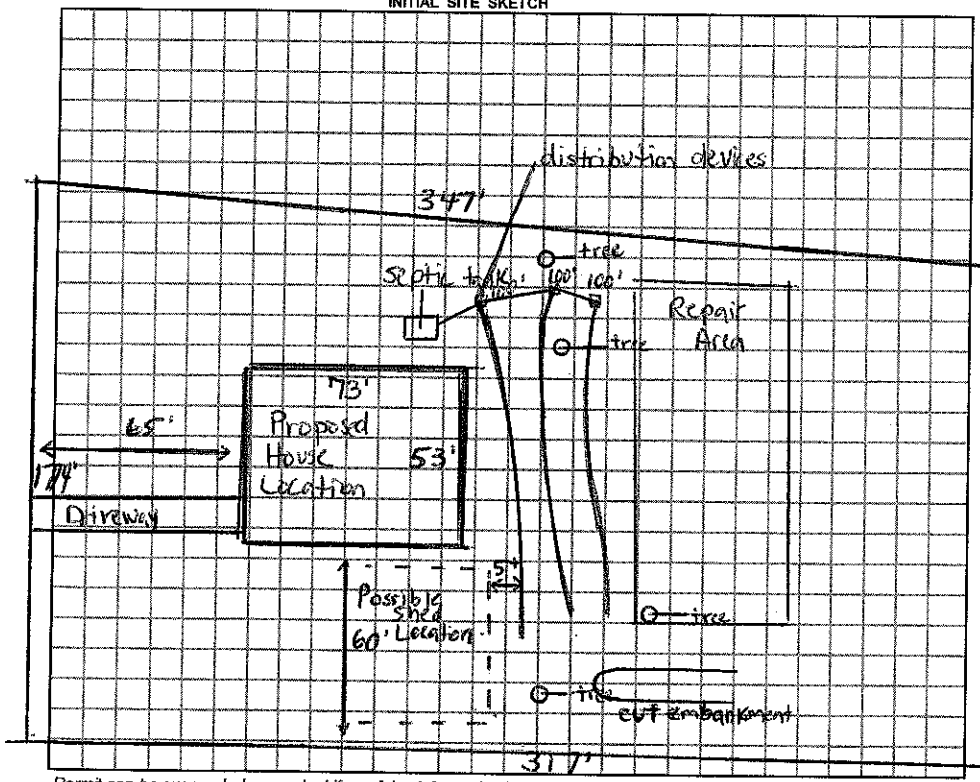

AS BUILT SKETCH

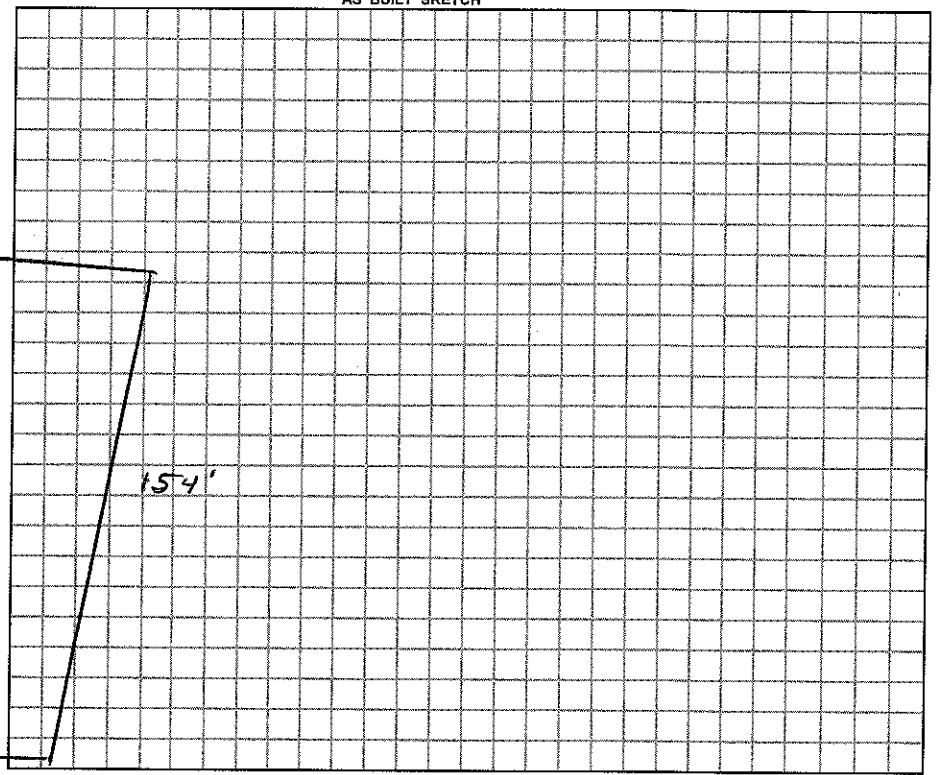

Permit can be suspended or revoked if any false information is supplied toward securing the permit / any unauthorized changes are made to the site / any unauthorized changes are made in the installation of the system.

☐ *IMPROVEMENT PERMIT w / plat valid without expiration.* ☑ *IMPROVEMENT PERMIT w / site plan valid for 60 mos.* ☐ *AUTHORIZATION TO CONSTRUCT valid for period equal to IMPROVEMENT PERMIT-not to exceed 60 mo.*

Owner / Applicant Signature: Date 12-30-08

Improvement Permit by: Date 12-29-08

Authorization to Construct by: Date 12-30-08

YOU SHOULD CONTACT A LOCATOR SERVICE PRIOR TO ANY EXCAVATION.

Installed by: Dolly Madison

Operation Permit by: Date: 4-24-09

Existing System Inspected by: Date:

WHITE COPY Environmental Health YELLOW COPY (Final) Owner / Applicant PINK COPY (Initial) Owner / Applicant