IREDELL COUNTY HEALTH DEPARTMENT

STATESVILLE 704-878-5305 MOORESVILLE 704-664-5281

IMPROVEMENT PERMIT / AUTHORIZATION TO CONSTRUCT / OPERATION PERMIT / EXISTING SYSTEM INSPECTION

PERMIT # 15259l PIN # 4757475576 DATE 9/24/08

OWNER or APPLICANT Pat Sherwood PHONE: Business Home: 704 622 9089

OWNER or APPLICANT ADDRESS 156 Painted Bunting Rd. Troutman, NC

LOCATION / DIRECTIONS I77 N. exit 54 (R) on 21 ~ 2 miles on left - Maple Creek Rd - 1st Road on left - Ravencrest Dr.

SUBDIVISION Highlands @ Maple Creek BLOCK / SECTION LOT # 1 LOT AREA 1.355 DESIGN FLOW 360 L.T.A.R. .3

Septic Tank 1000 Gallons: STB 1007 Date 10-7-08

Pump Tank Gallons: P T Date

Pump Make Model Serial #

Nitrification Field No Fields 1 No Lines 3 Linear Feet 300

Trench Width 36" Max. Trench Bottom Depth 36" Gravel Depth

☒ New System ☐ Repair ☐ Expansion System Type I II III IV V VI

System Description: 25% Reduction - Gravity

Repair System Description: 25% Reduction - Gravity

Maintenance Agreement Required ☒ YES ☐ NO

☒ GRAVITY ☐ PRESSURE

☒ Residence No. Bedrooms 3

☐ Business No. Persons

☐ Other No. Employees

☐ Slab ☒ Crawl Space

☐ Basement w/plumbing ☐ Basement w/o plumbing

Water Supply: ☐ Private ☒ Public ☐ Community


Comments / Conditions

(3) 3' x 100'


295'

Comments / Conditions

INITIAL SITE SKETCH

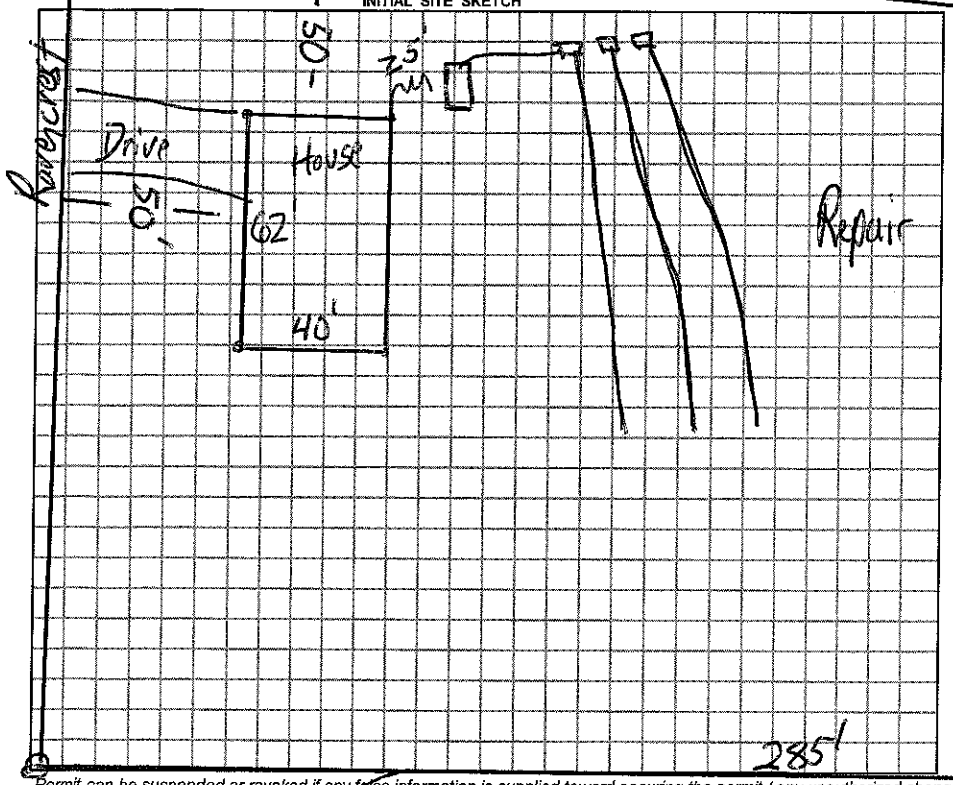

AS BUILT SKETCH

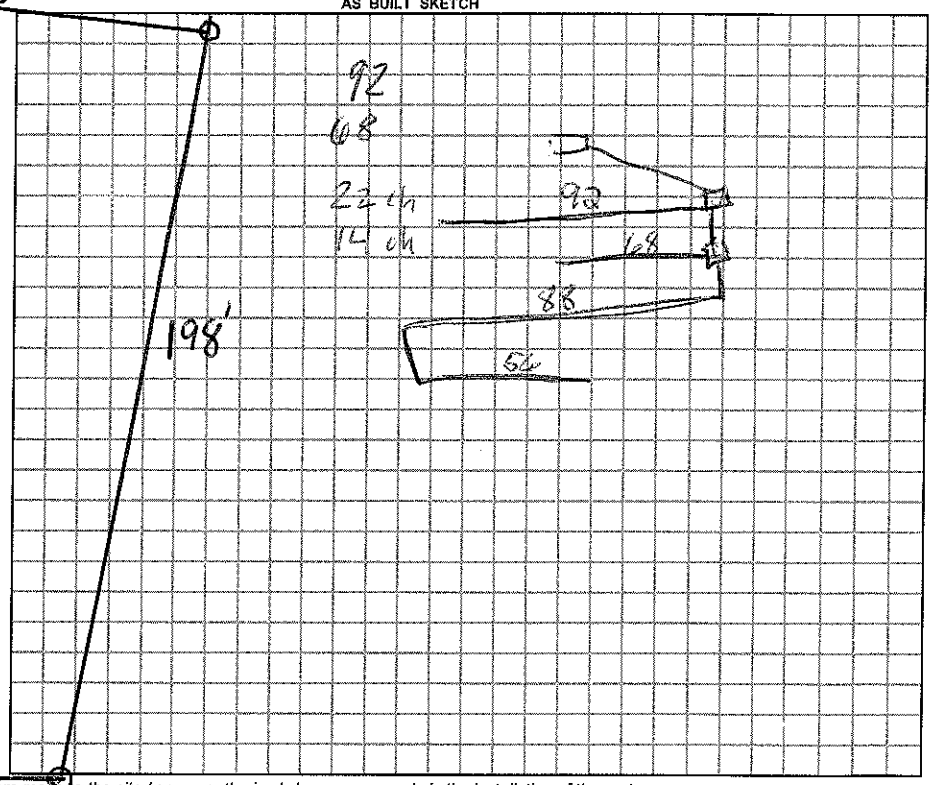

Permit can be suspended or revoked if any false information is supplied toward securing the permit / any unauthorized changes are made to the site / any unauthorized changes are made in the installation of the system.

☐ *IMPROVEMENT PERMIT w / plat valid without expiration.* ☒ *IMPROVEMENT PERMIT w / site plan valid for 60 mos.* ☒ *AUTHORIZATION TO CONSTRUCT valid for period equal to IMPROVEMENT PERMIT-not to exceed 60 mo.*

Owner / Applicant Signature: Date 10/4/08

Improvement Permit by: Date 9/24/08

Authorzation to Construct by: Date 9/24/08

YOU SHOULD CONTACT A LOCATOR SERVICE PRIOR TO ANY EXCAVATION.

Installed by: Kevin Bowles

Operation Permit by: Date: 12-30-08

Existing System Inspected by: Date:

WHITE COPY Environmental Health YELLOW COPY (Final) Owner / Applicant PINK COPY (Initial) Owner / Applicant