IREDELL COUNTY HEALTH DEPARTMENT - *ENVIRONMENTAL HEALTH* ☒ STATESVILLE OFFICE 704-878-5305 ☐ MOORESVILLE OFFICE 704-664-5281

IMPROVEMENT PERMIT / AUTHORIZATION TO CONSTRUCT @1 / OPERATION PERMIT @1 / EXISTING SYSTEM INSPECTION

PERMIT # 166695 PIN # 4757 47 9966 DATE June 20, 2011

OWNER Ralph Allison APPLICANT: Moorefield Builders, Inc PHONE: Home/Cell # Business # 704 880 6620

SITE ADDRESS 247 Maple Creek Dr, Statesville, NC OWNER / APPLICANT ADDRESS

SITE DIRECTIONS I-77 N ~2 miles North of Exit 54 T2 Maple Creek Dr. on left

SUBDIVISION Maple Creek BLOCK / SECTION LOT # 34 LOT AREA .67 Ac DESIGN FLOW 360 gpd L.T.A.R.

Septic Tank 1000 Gallons: STB 1012 Date 10-11-11
Pump Tank Gallons: P T Date
Pump Make Model Serial #
No. Nitrification Fields: No. Lines Linear Feet Existing
Trench Width Max. Trench Bottom Depth Gravel Depth

☐ New System ☐ Repair ☐ Expansion System Type I (II) III IV V VI
System Description: Relocation of Septic Tank + Drop Box
Repair System Description:
Maintenance Agreement Required ☐ YES ☒ NO
☒ GRAVITY ☐ PRESSURE


☒ Residence No. Bedrooms 3
☐ Business No. Persons
☐ Other No. Employees
☐ Slab ☒ Crawl Space
☐ Basement w/plumbing ☐ Basement w/o plumbing

Water Supply: ☐ Private ☒ Public ☐ Community

Comments / Conditions: Set New Septic Tank where shown. Remove 1st (upper line) drop box and approx 10-12' of Existing gravel and pipe. Move select Drop box if salvageable where shown (5' from foundation) and use solid pipe past outlet end of tank where gravel trench is at least 2 feet from side of tank.

Non-bedroom Addition to Existing house.

INITIAL SITE SKETCH

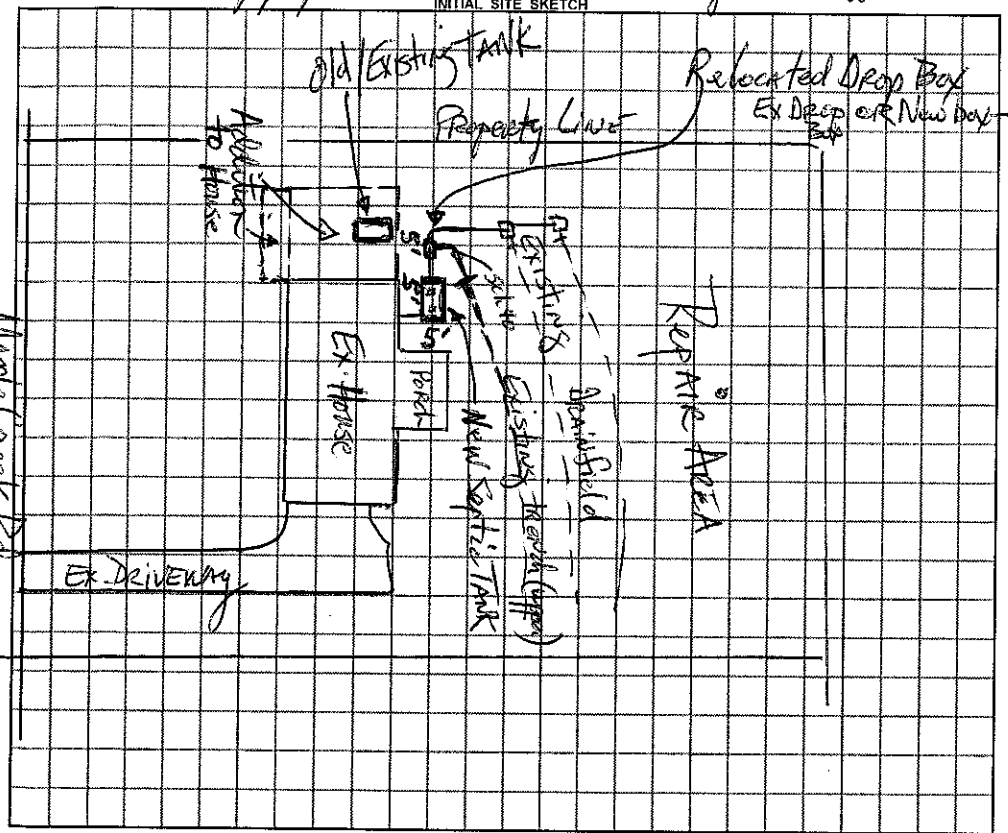

AS BUILT SKETCH

Permit can be suspended or revoked if any false information is supplied toward securing the permit / any unauthorized changes are made to the site / any unauthorized changes are made in the installation of the system.

☐ *IMPROVEMENT PERMIT* with plat valid without expiration. ☑ *IMPROVEMENT PERMIT* with plat valid without expiration. site plan valid 60 mo. ☑ *AUTHORIZATION TO CONSTRUCT* valid for period equal to IMPROVEMENT PERMIT--not to exceed 60 mo.

Owner / Applicant Signature: Date 7-1-11 Installed by: Stone Johnson

IMPROVEMENT PERMIT by: REHS Date 6-20-11 OPERATION PERMIT by: REHS Date 7-12-11

AUTHORIZATION TO CONSTRUCT by: REHS Date 6-20-11 Existing System Inspected by: REHS Date

YOU SHOULD CONTACT A LOCATOR SERVICE PRIOR TO ANY EXCAVATION

White Copy -- Environmental Health YELLOW COPY (Final) Owner / Applicant PINK COPY (Initial) Owner / Applicant