IREDELL COUNTY HEALTH DEPARTMENT

STATESVILLE 704-878-5305 MOORESVILLE 704-664-5281

IMPROVEMENT PERMIT / AUTHORIZATION TO CONSTRUCT / OPERATION PERMIT / EXISTING SYSTEM INSPECTION

PERMIT# 137155 PIN# 4757481492 DATE 8-10-06

OWNER OR APPLICANT Brian M. Tuthill PHONE: Business Home 704 682 4013

ADDRESS 495 Riverhill Rd

LOCATION 21 N 1 mi. past auto auction (L) Maple Creek (L) Four Winds, Prop on (R)

SUBDIVISION Maple Creek BLOCK / SECTION I LOT 21 LOT AREA .56 SITE CLASS PS DESIGN FLOW 360 L.T.A.R. .3

Septic Tank: 1000 Gallons; STB 1012 Date 5-14-06

Pump Tank: Gallons; PT Date

Pump Make: Model Serial No.

Nitrification Field: No Fields 1 Square Feet 1200 Linear Feet 300

No Lines 3 4 Trench Width 36" Max Trench Bottom Depth 36" Gravel Depth Gravity ☐ Pressure

☒ New System ☐ Repair ☐ Expansion System Type: I (II) III IV V VI

System Description: 25% Reduction - Gravity

Repair System Description: 50% LP Reduction

Maintenance Agreement Required: ☐ Yes ☒ No

☒ House/Mod. Home ☐ Mobile Home ☐ Business ☐ Other

No. Bedrooms 3 No. Persons No. Employees

Water Supply: ☒ Individual ☐ Public ☐ Community


☐ Slab ☒ Crawl Space ☐ Basement w/plumbing ☐ Basement wo/plumbing

Comments:/Conditions:

Comments:/Conditions:

Yellow Filter
ST marker

INITIAL SITE SKETCH

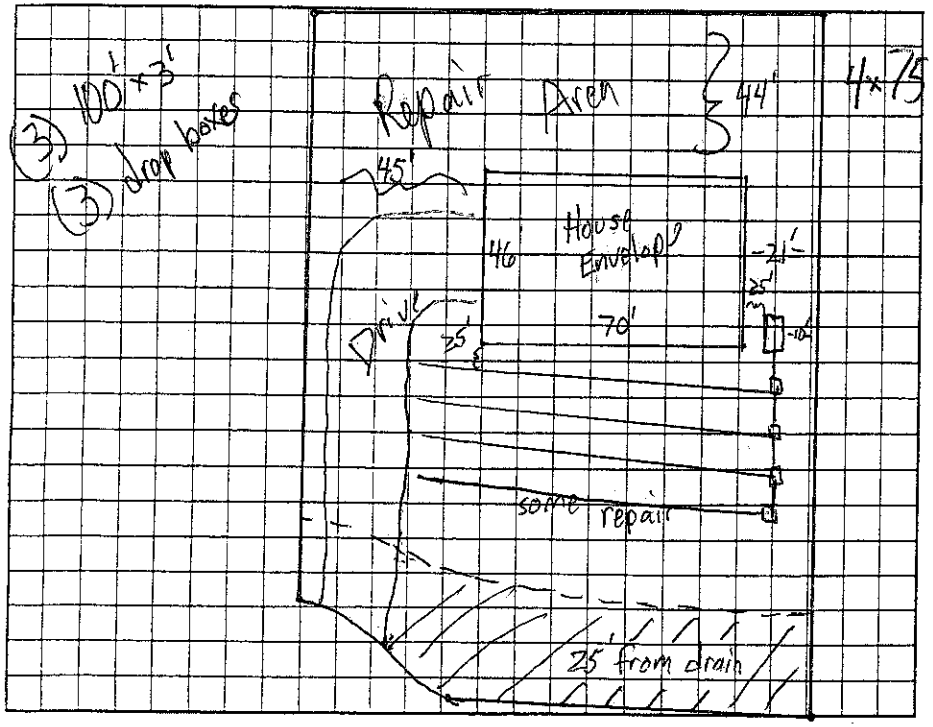

AS BUILT SKETCH

Permit can be suspended or revoked if any false information is supplied toward securing the permit/any unauthorized changes are made to the site/any unauthorized changes are made in the installation of the system. Improvement Permit with plat valid without expiration ☐ Improvement Permit with site plan valid for sixty months ☐ Authorization to Construct is valid for a period equal to that of Improvement Permit – not to exceed sixty months.

Signed: Matt Mazurkiewicz date 8-17-06 Installed by: Steve Jordan

Improvement Permit by: James Strange date 8-10-06 Operation Permit by: James Shinn date 11/28/06

Authorization to Construct by: James Shinn date 8-17-06 Existing System Inspection by: date

HEALTH DEPT. COPY: WHITE OWNER COPY (FINAL): YELLOW OWNER COPY (INITIAL): PINK