IREDELL COUNTY HEALTH DEPARTMENT

STATESVILLE 704-878-5305 (C1) MOORESVILLE 704-664-5281

IMPROVEMENT PERMIT / AUTHORIZATION TO CONSTRUCT / OPERATION PERMIT / EXISTING SYSTEM INSPECTION

PERMIT# 111168 PIN# 4757-48-2009 DATE 02-20-03

OWNER OR CONTRACTOR JOHN'S WELDING PHONE: Business 880-6620 Home 704-873-7885

ADDRESS 1516 MOORESVILLE HWY STATESVILLE, NC 28625

LOCATION 21 NORTH ⓛ MAPLE CREEK ⓡ FOUR DOGS, LOT # 26, 4TH ON LEFT

SUBDIVISION MAPLE CREEK BLOCK / SECTION 1 LOT 26 LOT AREA 1.100 AC SITE CLASS. PS DESIGN FLOW 360 L.T.A.R. .3

Septic Tank: 1000 Gallons; STB 1012 Date 9-22-02
Pump Tank: ____ Gallons; PT ____ Date ____
Pump Make: ____ Model ____ Serial No. ____
Nitrification Field: No Fields 1 Square Feet 1200" Linear Feet 400"
No Lines 4 Trench Width 36" Max Trench Bottom Depth 36" Gravel Depth 12"

☒ New System ☐ Repair System Type: I, II, III, IV, V, VI
System Description: CONV 6RAN
Repair System Description: 6RAN 25% RED
Maintenance Agreement Required: ☐ Yes ☒ No


☒ House/Mod. Home No. Bedrooms 3
☐ Mobile Home No. Bathrooms 2
☐ Business No. Employees ____
☐ Other ____
☐ Slab ☒ Crawl Space ☐ Basement w/plumbing ☐ Basement wo/plumbing

Water Supply: ☐ Individual ☒ Public ☐ Community


Comments:/Conditions: ① MAINTAIN SETBACKS ② INSTALL LINES ON CONTOURS ③ SYSTEM & HOUSE IS FLAGGED OUT ④ MAINTAIN STUBOUT HIGH ENOUGH TO ACHIEVE GRAVITY FALL TO TANK & FIRST LINE. ⑤ FILL & PACK WASHOUT & MAINTAIN SETBACKS

Comments:/Conditions: ⑥ BUILDER WILL REMOVE CATCH BASIN ⑦ FIRST LINE CAN USE A DROP BOX WITH SPEED LEVELER SO LINE ISN'T THAT DEEP, THE LAST 3 LINES STILL USES DROP BOXES, THE DIRT BOX & SPEED LEVELER ACTS AS A DROP BOX.

INITIAL SITE SKETCH 1" = 50'

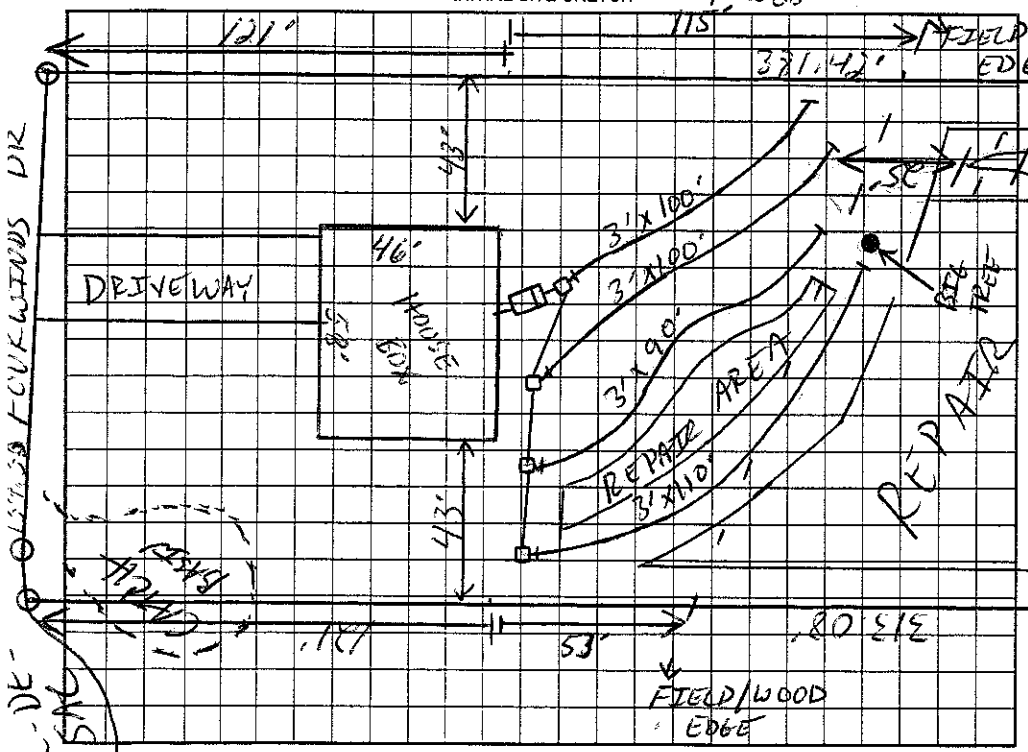

AS BUILT SKETCH

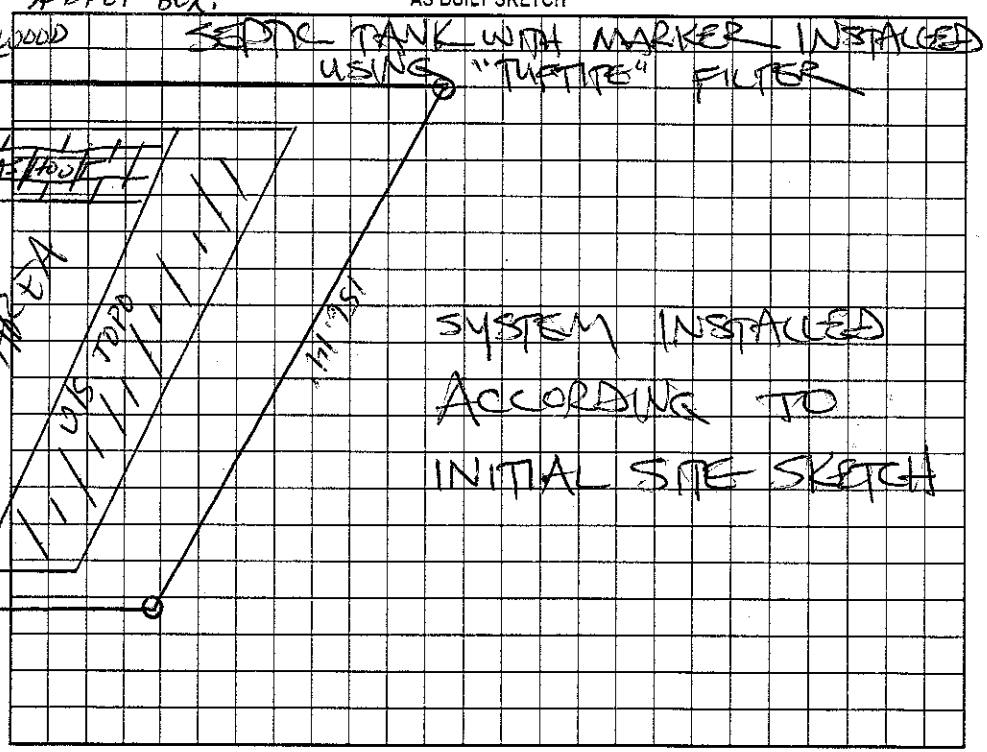

Permit can be suspended or revoked if any false information is supplied toward securing the permit/any unauthorized changes are made to the site/any unauthorized changes are made in the installation of the system. Improvement Permit with plat valid without expiration. Improvement Permit with site plan valid for sixty months. Authorization to Construct is valid for a period equal to that of Improvement Permit – not to exceed sixty months.

Signed: [signature] date 2/28/03 Installed by: STEVE JORDAN

Improvement Permit by: [signature] RS date 02-20-03 Operation Permit by: STEVE HENDRICK date 5-14-03

Authorization to Construct by: [signature] RS date 02-20-03 Existing System Inspection by: ____ date ____

HEALTH DEPT. COPY: WHITE OWNER COPY (FINAL): YELLOW OWNER COPY (INITIAL): PINK