IREDELL COUNTY HEALTH DEPARTMENT

STATESVILLE 704-878-5305 (A) MOORESVILLE 704-664-5281

IMPROVEMENT PERMIT / AUTHORIZATION TO CONSTRUCT / OPERATION PERMIT / EXISTING SYSTEM INSPECTION

PERMIT# 122061 PIN# 4757-48-3431 DATE 6-29-04

OWNER OR CONTRACTOR COOL SPRINGS BUILDERS, INC. PHONE: Business 336-399-5943 Home 704-883-0839

ADDRESS 345 OLD MOCKSVILLE ROAD, STATESVILLE, NC 28625

LOCATION US 21 NORTH, TL MAPLE CREEK DR, TL FOUR WINDS DRIVE, 2ND LOT ON RIGHT BEFORE CUL-DE-SAC

SUBDIVISION MAPLE CREEK BLOCK / SECTION 1 LOT 20 LOT AREA 0.586 ACRE SITE CLASS. PS DESIGN FLOW 360 L.T.A.R. 0.3 GPD/FT²

Septic Tank: 1000 Gallons; STB 1012 Date 10-16-04
Pump Tank: _____ Gallons; PT _____ Date _____
Pump Make: _____ Model _____ Serial No. _____
Nitrification Field: No Fields 1 Square Feet EQ. P 1200 Linear Feet 300
No Lines FIVE Trench Width 36" Max Trench Bottom Depth 36" Gravel Depth N/A

☑ New System ☐ Repair System Type: I, II, (III), IV, V, VI
System Description: 25% REDUCTION GRAVITY
Repair System Description: 50% REDUCTION PUMP
Maintenance Agreement Required: ☐ Yes ☑ No LOW-PRESSURE ☐ Other

☑ House/Mod. Home No. Bedrooms 3
☐ Mobile Home No. Bathrooms ____
☐ Business No. Employees ____
☐ Slab ☐ Crawl Space ☑ Basement w/plumbing ☐ Basement wo/plumbing


Water Supply: ☐ Individual ☑ Public ☐ Community

Comments:/Conditions: INSTALL 25% REDUCTION SYSTEM ON CONTOUR AS SHOWN

SCALE: 1"=40'

Comments:/Conditions: SEPTIC TANK WITH RISERS INSTALLED USING "TUFTITE" FILTER

INITIAL SITE SKETCH

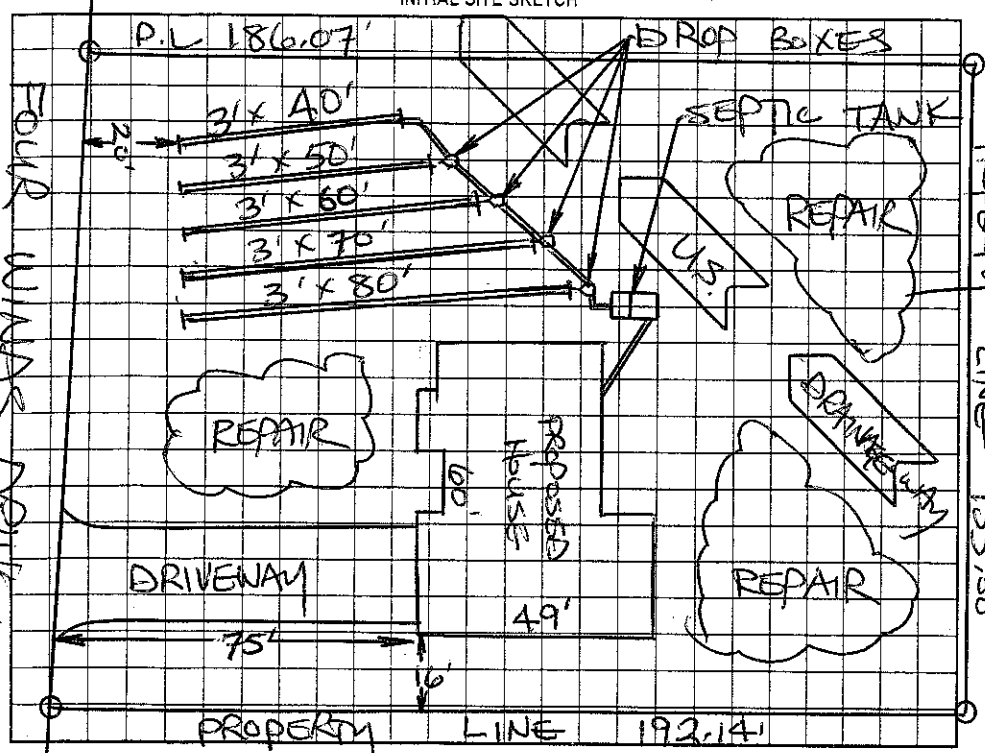

AS BUILT SKETCH

SYSTEM INSTALLED ACCORDING TO INITIAL SITE SKETCH

Permit can be suspended or revoked if any false information is supplied toward securing the permit/any unauthorized changes are made to the site/any unauthorized changes are made in the installation of the system. Improvement Permit with plat valid without expiration. Improvement Permit with site plan valid for sixty months. Authorization to Construct is valid for a period equal to that of Improvement Permit – not to exceed sixty months.

Signed: _____ date 6-29-04 Installed by: PIEDMONT BACKHOE

Improvement Permit by: STEVE HEDRICK date 6-29-04 Operation Permit by: STEVE HEDRICK date 12-16-04

Authorization to Construct by: STEVE HEDRICK date 6-29-04 Existing System Inspection by: _____ date _____

HEALTH DEPT. COPY: WHITE OWNER COPY (FINAL): YELLOW OWNER COPY (INITIAL): PINK