IREDELL COUNTY HEALTH DEPARTMENT

STATESVILLE 704-878-5305 (C1) MOORESVILLE 704-664-5281

IMPROVEMENT PERMIT / AUTHORIZATION TO CONSTRUCT / OPERATION PERMIT / EXISTING SYSTEM INSPECTION

(C1)

PERMIT# 115127 PIN# 4757-48-4460 DATE 9-23-03

OWNER OR ~~CONTRACTOR~~ STAN SIERA PHONE: Business 704-880-6620 Home 336-921-2150

ADDRESS 966 CHERRY GROVE MORAVIAN FALLS, NC 28654

LOCATION US 21 NORTH, TL MAPLE CREEK DRIVE, TL FOUR WINDS DR 3RD ON RIGHT BEFORE CUL-DE-SAC

SUBDIVISION MAPLE CREEK BLOCK / SECTION ____ LOT 19 LOT AREA 0.605 ACRE SITE CLASS. PS DESIGN FLOW 360 L.T.A.R. 0.90 SPD/FT2

Septic Tank: 1000 Gallons; STB 1012 Date 8-4-03
Pump Tank: ____ Gallons; PT ____ Date ____
Pump Make: ____ Model ____ Serial No. ____
Nitrification Field: No Fields 1 Square Feet 900 Linear Feet 300
No Lines FIVE Trench Width 36" Max Trench Bottom Depth 36" Gravel Depth 12"

☑ New System ☐ Repair System Type: I, II, III, IV, V, VI
System Description: CONVENTIONAL GRAVITY
Repair System Description: CONV. PUMP GRAVITY
Maintenance Agreement Required: ☐ Yes ☑ No


☑ House/Mod. Home No. Bedrooms 3
☐ Mobile Home No. Bathrooms 2½
☐ Business No. Employees ____
☐ Other ____
☐ Slab ☐ Crawl Space ☐ Basement w/plumbing ☑ Basement wo/plumbing

Water Supply: ☐ Individual ☑ Public ☐ Community

Comments:/Conditions: REMOVE EXISTING FIELD TERRACE

Comments:/Conditions: SEPTIC TANK WITH MARKER INSTALLED USING "TUFTITE" FILTER

INITIAL SITE SKETCH

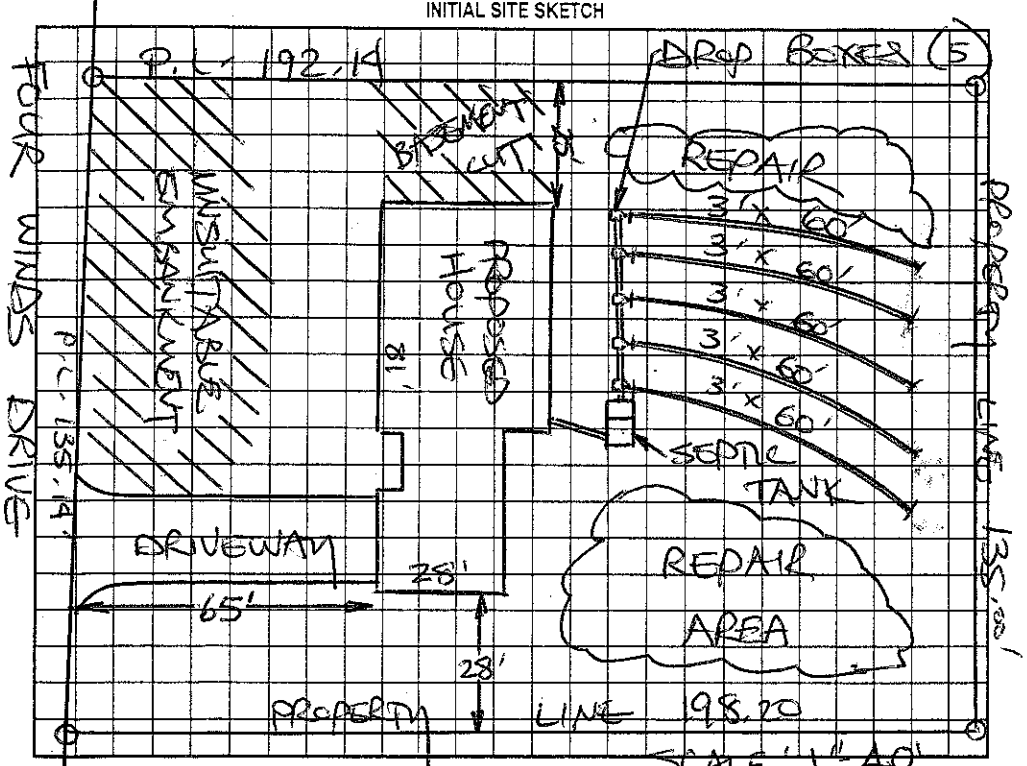

AS BUILT SKETCH

SYSTEM INSTALLED ACCORDING TO INITIAL SITE SKETCH

Permit can be suspended or revoked if any false information is supplied toward securing the permit/any unauthorized changes are made to the site/any unauthorized changes are made in the installation of the system. Improvement Permit with plat valid without expiration. Improvement Permit with site plan valid for sixty months. Authorization to Construct is valid for a period equal to that of Improvement Permit – not to exceed sixty months.

Signed: + Matt Moorefield date 9-23-03 Installed by: STEVE JORDAN

Improvement Permit by: STEVE HEDRICK date 9-23-03 Operation Permit by: STEVE HEDRICK date 1-16-04

Authorization to Construct by: STEVE HEDRICK date 9-23-03 Existing System Inspection by: ____ date ____

HEALTH DEPT. COPY: WHITE OWNER COPY (FINAL): YELLOW OWNER COPY (INITIAL): PINK