IREDELL COUNTY HEALTH DEPARTMENT

STATESVILLE 704-878-5305 MOORESVILLE 704-664-5281

IMPROVEMENT PERMIT / AUTHORIZATION TO CONSTRUCT / OPERATION PERMIT / EXISTING SYSTEM INSPECTION

PERMIT# 13173 PIN# ~~4757487337~~ 4757487337 DATE 4-4-06

OWNER OR CONTRACTOR Matt Gaither PHONE: Business 704-902 4639 Home

ADDRESS 444 Hunt RD Olin NC 28660

LOCATION 21 N to Maple Creek to Town Winds Cotton Right

SUBDIVISION Maple Crest BLOCK / SECTION 1 LOT 17 LOT AREA SITE CLASS. B DESIGN FLOW 360 L.T.A.R. .3

Septic Tank: 1000 Gallons; STB 1000 Date 7-26-05

Pump Tank: Gallons; PT Date

Pump Make: Model Serial No.

Nitrification Field: No Fields Square Feet 200 Linear Feet 300

No Lines 5 Trench Width 36 Max Trench Bottom Depth 36 Gravel Depth NA

☒ New System ☐ Repair System Type: I II III IV V VI

System Description: 25% Growth

Repair System Description: 50% Growth

Maintenance Agreement Required: ☐ Yes ☐ No

☐ House/Mod. Home No. Bedrooms 3

☐ Mobile Home No. Bathrooms

☐ Business No. Employees

☐ Other


☐ Slab ☒ Crawl Space ☐ Basement w/plumbing ☐ Basement wo/plumbing

Water Supply: ☐ Individual ☒ Public ☐ Community

Comments/Conditions: Install on contour Maintain all setbacks (5) drop Boxes

Comments/Conditions: Red Mylock filter pump has risers

INITIAL SITE SKETCH

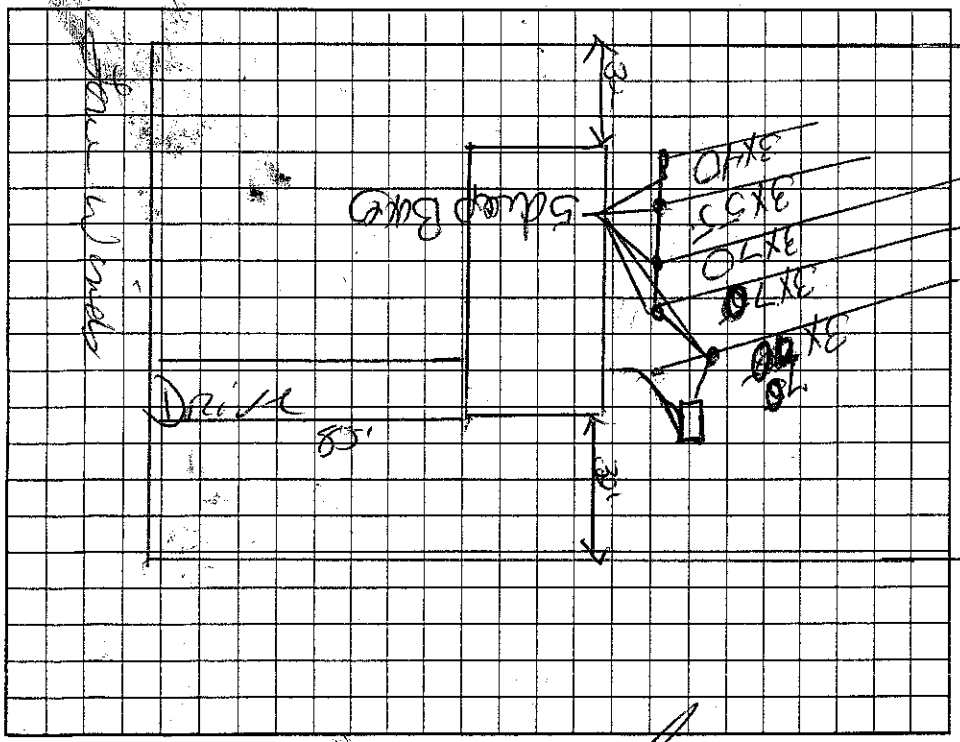

AS BUILT SKETCH

Permit can be suspended or revoked if any false information is supplied toward securing the permit/any unauthorized changes are made to the site/any unauthorized changes are made in the installation of the system. Improvement Permit with plat valid without expiration. Improvement Permit with site plan valid for sixty months. Authorization to Construct is valid for a period equal to that of Improvement Permit – not to exceed sixty months.

Signed: date

Improvement Permit by: date 4-4-06

Authorization to Construct by: date 4-4-06

Installed by: Brent Gaither

Operation Permit by: date 4-21-06

Existing System Inspection by: date

HEALTH DEPT. COPY: WHITE OWNER COPY (FINAL): YELLOW OWNER COPY (INITIAL): PINK