IREDELL COUNTY HEALTH DEPARTMENT

Statesville Office (704) 878-5305 Mooresville Office (704) 660-3625 PERMIT # 218391

IMPROVEMENT PERMIT / AUTHORIZATION TO CONSTRUCT / OPERATION PERMIT / EXISTING SYSTEM

PIN # 4757488009

APPLICANT: Jeffrey Miller APPLICANT ADDRESS: 484 Summit Ave Statesville NC

SITE ADDRESS: 127 Four Winds Dr Statesville NC PHONE: 316-644-7661 ALT. PHONE: N/A

SITE DIRECTIONS: 77N T/R 21 T/L Maple Creek T/L Four Winds Lot on left

SUBDIVISION: Maple Creek SECTION: 5J LOT # 32 LOT AREA: 0.640ac DESIGN FLOW: 360 L.T.A.R.: 0.3

Septic Tank 1000 (gal) STB 1012 Date 4-17-16
Pump Tank (gal) PT Date
Pump Make Model Serial #
Nitrification Fields 1 # Lines 3 Linear Ft: 300
Trench Width 36" Max. Trench Bottom Depth 24" Gravel Depth N/A

[X] New System [ ] Repair [ ] Expansion System Type: I II [III] IV V VI
System Description: 25% Reduction
Repair System Description: 50% Reduction
Maintenance Agreement Required: [ ] YES [X] NO
[X] GRAVITY [ ] PRESSURE

[X] Residence No. Bedrooms 3
[ ] Business No. Persons 6
[ ] Other No. Employees
[ ] Slab [X] Crawl Space
[ ] Basement w/plumbing [ ] Basement w/o plumbing

Water Supply: [ ] Private [X] Public [ ] Community

Comments / Conditions: Install per plan by Kathleen Saunders (The Oaks Group)

INITIAL SITE SKETCH

See plan by the Oaks Group PA

AS BUILT SKETCH

Permit can be suspended or revoked if any false information is supplied toward securing the permit / any unauthorized changes are made to the site / any unauthorized changes are made in the installation of the system. CONTACT A LOCATOR SERVICE PRIOR TO ANY EXCAVATION

[ ] IMPROVEMENT PERMIT *with plat* valid without expiration. [X] IMPROVEMENT PERMIT *with site plan* valid for 60 mos. [X] AUTHORIZATION TO CONSTRUCT valid for period equal to IMPROVEMENT PERMIT--not to exceed 60 mo.

Owner / Applicant Signature: Date: 06/13/16 Installed by: Steve Jordan


IMPROVEMENT PERMIT by: Date: 06/06/16 OPERATION PERMIT by: Date: 9/26/16

AUTHORIZATION TO CONSTRUCT by: Date: 06/14/16 Existing System Inspected by: Date:

Health Dept. Copy - WHITE Applicant (Final Approval) - YELLOW Applicant (Conditional Approval) - PINK

CONNECTGIS WEB HOSTING

Iredell County

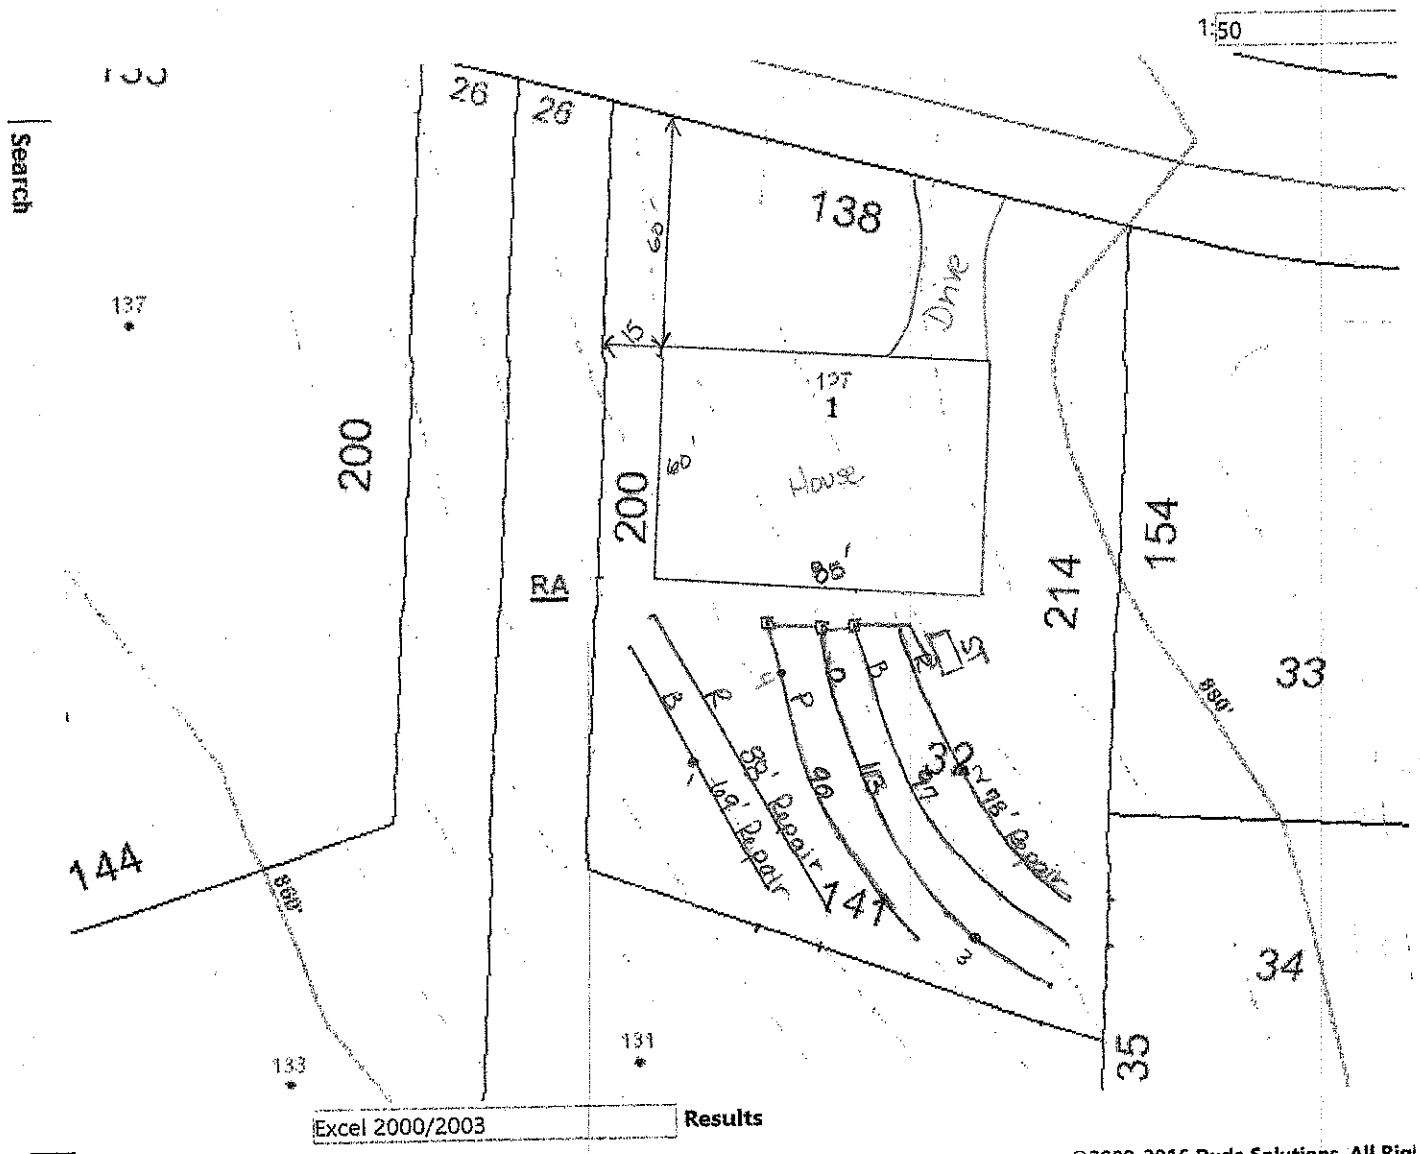

1" = 50'

N