IREDELL COUNTY HEALTH DEPARTMENT

STATESVILLE 704-878-5305 (C1) MOORESVILLE 704-664-5281

IMPROVEMENT PERMIT / AUTHORIZATION TO CONSTRUCT / OPERATION PERMIT / EXISTING SYSTEM INSPECTION

(C) PERMIT# 121001 PIN# 4757-48-6620 9170 DATE 11-17-04

OWNER OR CONTRACTOR MOOREFIELD BUILDERS, INC PHONE: Business 704-880-6603 Home 704-880-6620

ADDRESS 1516 MOCKSVILLE HWY, STATESVILLE NC 28625

LOCATION US 21 NORTH, TL MAPLE CREEK DRIVE, LOT AT END ON LEFT

SUBDIVISION MAPLE CREEK BLOCK / SECTION I LOT 33 LOT AREA 0.716 ACRE SITE CLASS PS DESIGN FLOW 360 L.T.A.R. 0.30 GPD/FT²

Septic Tank: 1000 Gallons; STB 1012 Date 8-30-04
Pump Tank: _____ Gallons; PT _____ Date _____
Pump Make: _____ Model _____ Serial No. _____
Nitrification Field: No Fields 1 Square Feet 1200 Linear Feet 400
No Lines FOUR Trench Width 36" Max Trench Bottom Depth 36" Gravel Depth 12"

☑ New System ☐ Repair System Type: I, II, III, IV, V, VI
System Description: CONVENTIONAL GRAVITY
Repair System Description: 50% REDUCTION, LOW PRESSURE
Maintenance Agreement Required: ☐ Yes ☑ No ☐ Other _____
☐ Slab ☑ Crawl Space ☐ Basement w/plumbing ☐ Basement wo/plumbing


☑ House/Mod. Home No. Bedrooms 3
☐ Mobile Home No. Bathrooms _____
☐ Business No. Employees _____

Water Supply: ☐ Individual ☑ Public ☐ Community

Comments:/Conditions: REMOVE EXISTING FIELD TERRACE
KEEP SYSTEM MINIMUM 15' FROM TOP OF SLOPE OF EMBANKMENT
PROPERTY LINE 214.63'

Comments:/Conditions: SEPTIC TANK WITH MARKER INSTALLED USING "TUFTITE" FILTER.

INITIAL SITE SKETCH

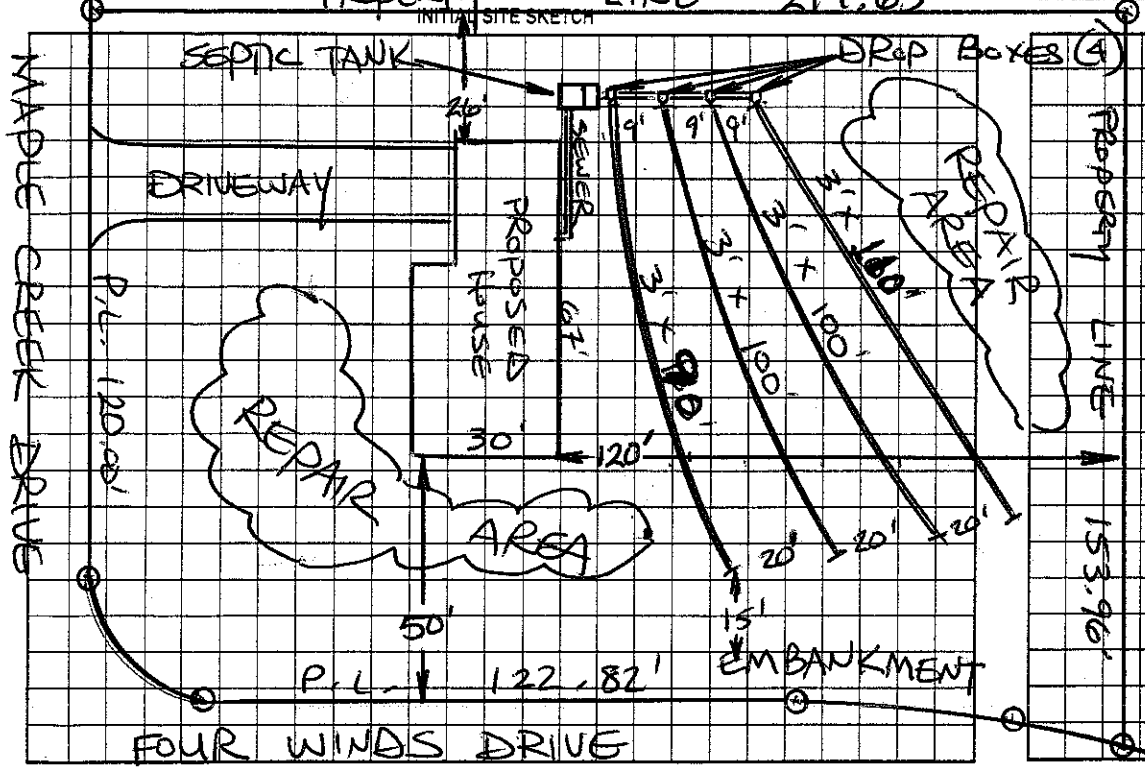

AS BUILT SKETCH



Permit can be suspended or revoked if any false information is supplied toward securing the permit/any unauthorized changes are made to the site/any unauthorized changes are made in the installation of the system. Improvement Permit with plat valid without expiration. Improvement Permit with site plan valid for sixty months. Authorization to Construct is valid for a period equal to that of Improvement Permit – not to exceed sixty months.

Signed: Matthew A Moorefield date 11-18-04 Installed by: PIEDMONT BACKHOE

Improvement Permit by: STEVE HEDRICK date 11-17-04 Operation Permit by: STEVE HEDRICK date 4-11-05

Authorization to Construct by: STEVE HEDRICK date 11-17-04 Existing System Inspection by: _____ date _____

HEALTH DEPT. COPY: WHITE OWNER COPY (FINAL): YELLOW OWNER COPY (INITIAL): PINK