IREDELL COUNTY HEALTH DEPARTMENT

Statesville Phone TR 3-7271 Mooresville Phone NO 3-1271

PERMIT TO INSTALL SEPTIC TANK

Permit NO. _____ Permit Date June 21 1960

Owner Rev Graham Worten Address _____

Installed By Rev. Paul Moore Address _____

Location of Property out #21 North Post Prison Camp


Rt Lt in Bell Mtn development, 3rd Drive Left

Tank		Capacity		Length of Lines		Fixtures	
Block	(✓)	800	(✓)	150'	(✓)	No. of Baths	(1)
Precast	( )	900	( )	175'	( )	Dishwasher	( )
		1000	( )	200'	( )	Garbage Grdr.	( )
		1100	( )	225'	( )	Auto-Washer	( )
		1200	( )	250'	( )	Other	_____
		Other	_____	Other	_____		

NOTIFY HEALTH DEPARTMENT AT LEAST EIGHT HOURS BEFORE TANK IS TO BE INSPECTED.

Final Inspection June 21 1960 Approved (✓) Disapproved ( )

Remarks Well 65' deep

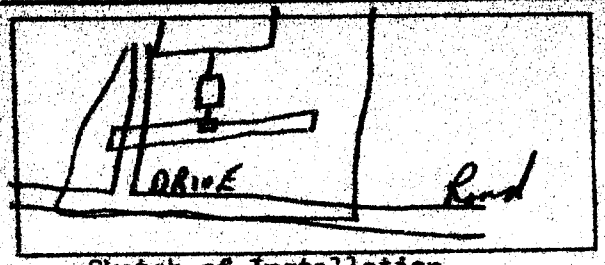

Sketch of Installation

Raymond G. Johnson

Sanitarian