IREDELL COUNTY HEALTH DEPARTMENT

Statesville Phone TR 3-7271 — Mooresville Phone NO 3-1271

PERMIT TO INSTALL SEPTIC TANK

Permit NO._____ Permit Date_____ 19___

Owner Mr. Graham Swaim Address Statesville

Installed By Ray Ford Address Statesville

Location of Property Bulk mobile home development


on hwy. 21, Fifth house on right

Tank	Capacity	Length of Lines	Fixtures
Block ( )	800 ( )	150' ( )	No. of Baths (1)
Precast ( )	900 ( )	175' ( )	Dishwasher ( )
Owner ( )	1000 (✓)	200' ( )	Garbage Grdr. ( )
	1100 ( )	225' (✓)	Auto-Washer (✓)
	1200 ( )	250' ( )	Other_____
	Other_____	Other_____	

NOTIFY HEALTH DEPARTMENT AT LEAST EIGHT HOURS BEFORE TANK IS TO BE INSPECTED.

Final Inspection _____ 19___ Approved ( ) Disapproved ( )

Remarks Owner

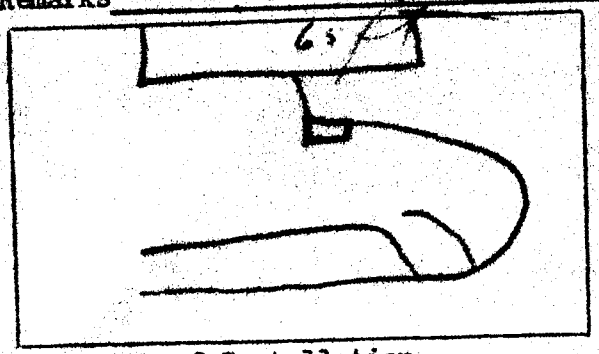

Sketch of Installation

_____

Sanitarian