IREDELL COUNTY HEALTH DEPARTMENT

Statesville Phone TR 3-7271 — Mooresville Phone NO 3-1271

PERMIT TO INSTALL SEPTIC TANK

Permit NO. [redacted] Rev. Graham Permit Date 11-12-59 195

Owner [redacted] Woote Address Bell mead Dalp

Installed By CLYDE HOKE Address


Location of Property past prison camp on 21 N. To new delpa to Right 1st new brick on R.

Tank		Capacity		Length of Lines		Fixtures	
Block	( )	800	( )	150'	(4)	No. of Baths	( )
Precast	(4)	900	(4)	175'	( )	Dishwasher	( )
		1000	( )	200'	( )	Garbage Grdr.	( )
		1100	( )	225'	( )	Auto-Washer	( )
		1200	( )	250'	( )	Other	
		Other		Other			

NOTIFY HEALTH DEPARTMENT AT LEAST EIGHT HOURS BEFORE TANK IS TO BE INSPECTED.

Final Inspection 11-12-59 195 Approved ( ) Disapproved ( )

Remarks delpa Not for washer well 50'

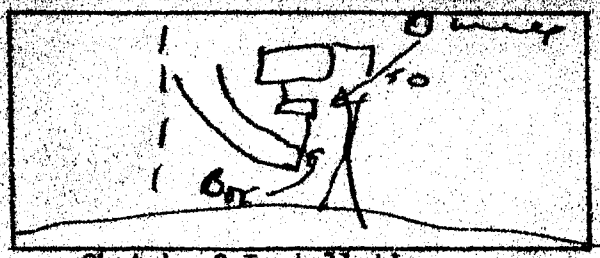

Sketch of Installation

Rd.

Sanitarian