IREDELL COUNTY HEALTH DEPARTMENT - *ENVIRONMENTAL HEALTH* ☒ STATESVILLE OFFICE 704-878-5305 ☐ MOORESVILLE OFFICE 704-664-5281

IMPROVEMENT PERMIT / AUTHORIZATION TO CONSTRUCT / OPERATION PERMIT / EXISTING SYSTEM INSPECTION

PERMIT # Repair PIN # 4757543680 DATE 6-7-12

OWNER Lucille W. Harwell APPLICANT: PHONE: Home/Cell # 704-876-1334 Business # 704 872 0479

SITE ADDRESS 109 Country View Rd. OWNER / APPLICANT ADDRESS

SITE DIRECTIONS Hwy 21N, (R) on Country View Rd, 2nd house on (L)

SUBDIVISION Belle Meade BLOCK / SECTION LOT # 3 LOT AREA .519 DESIGN FLOW 360 L.T.A.R. .3

Septic Tank Ex. Gallons: STB Ex Date Ex

Pump Tank Gallons: P T Date

Pump Make Model Serial #:

No. Nitrification Fields: 1 No. Lines 2 Linear Feet 225 (ex)

Trench Width ex Max. Trench Bottom Depth ex

☐ New System ☒ Repair ☐ Expansion System Type I (II) III IV V VI

System Description: GTR or Cinders w/ TCT

Repair System Description:

Maintenance Agreement Required ☐ YES ☒ NO

Gravel Depth 12 (ex) ☒ GRAVITY ☐ PRESSURE


☒ Residence No. Bedrooms 3 ☐ Business No. Persons ☐ Other No. Employees ☐ Slab ☐ Crawl Space ☒ Basement w/plumbing ☐ Basement w/o plumbing

Water Supply: ☒ Private ☐ Public ☐ Community


Comments / Conditions Hard pipe supply past large tree. near tank. Replace tank if necessary. Add a drop box to first line and create dam at beginning on line to ensure 1st line gets proper distribution. Compact soil at dam area to prevent leakage.

1Q4W

INITIAL SITE SKETCH

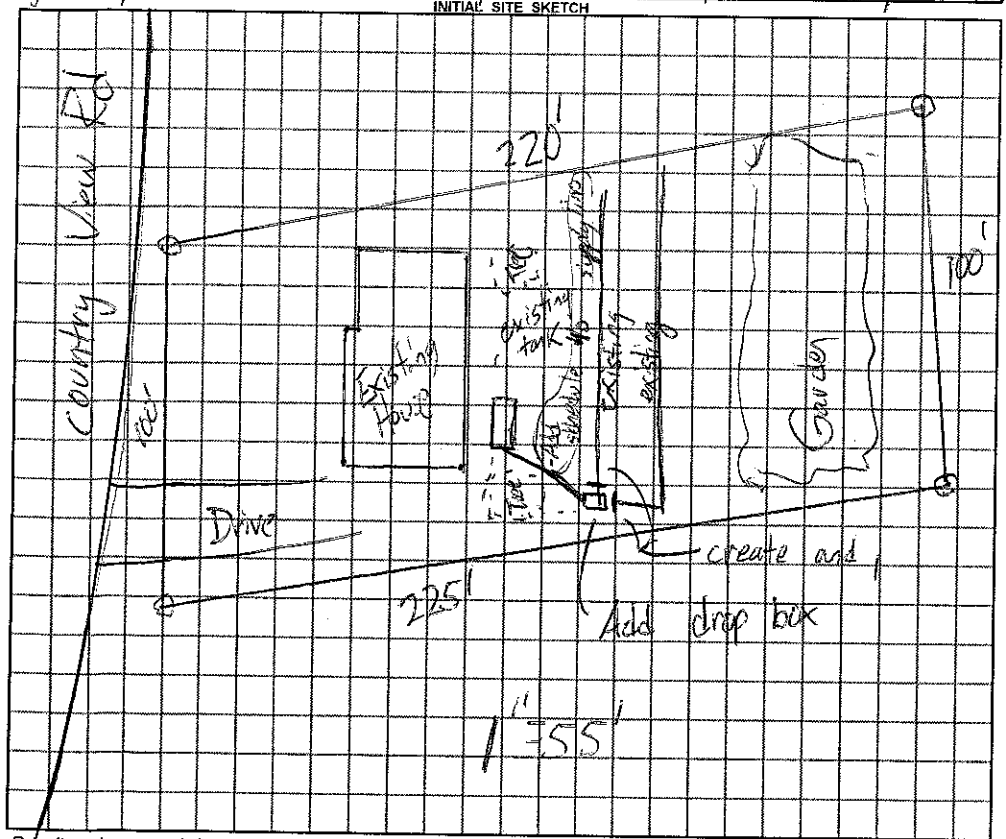

AS BUILT SKETCH

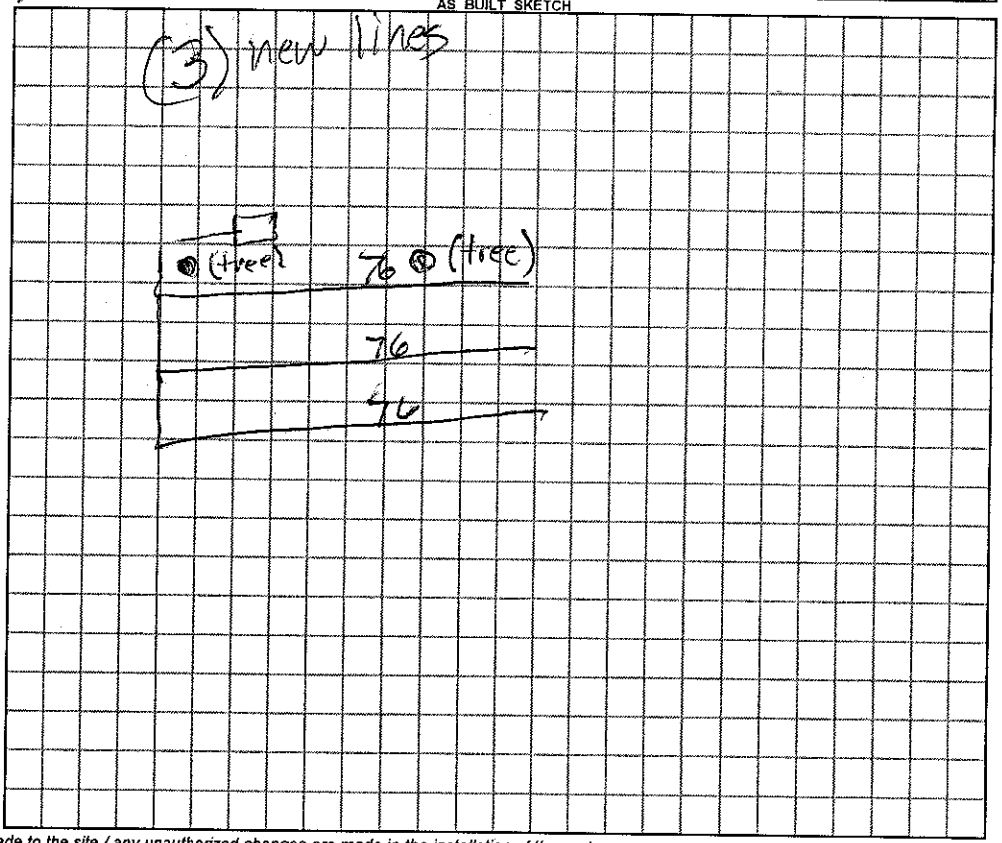

Permit can be suspended or revoked if any false information is supplied toward securing the permit / any unauthorized changes are made to the site / any unauthorized changes are made in the installation of the system.

☐ ***IMPROVEMENT PERMIT*** with plat valid without expiration. ☒ ***IMPROVEMENT PERMIT*** with plat valid without expiration. site plan valid to final ☒ ***AUTHORIZATION TO CONSTRUCT*** valid for period equal to IMPROVEMENT PERMIT–not to exceed 60 mo.

Owner / Applicant Signature: Lucille W. Harwell Date 6-8-12 Installed by: James Huddles

IMPROVEMENT PERMIT by: REHS Date 6-7-12 OPERATION PERMIT by: REHS Date 6-26-12

AUTHORIZATION TO CONSTRUCT by: REHS Date 6-7-12 Existing System Inspected by: REHS Date

YOU SHOULD CONTACT A LOCATOR SERVICE PRIOR TO ANY EXCAVATION

White Copy – Environmental Health YELLOW COPY (Final) Owner / Applicant PINK COPY (Initial) Owner / Applicant