IREDELL COUNTY HEALTH DEPARTMENT

Statesville Phone TR 3-7271 Mooresville Phone NO 3-1271

PERMIT TO INSTALL SEPTIC TANK

Permit NO. _____ Permit Date 9 14 1959

Owner White Address Hwy 21 N.

Installed By CLYDE HOKE BX 312 Address _____

Location of Property [illegible] N. Ca. Straight past Prison Camp.


Leave from Negro Church L.

Tank		Capacity		Length of Lines		Fixtures	
Block	( )	800	(✓)	150'	(✓)	No. of Baths	(1)
Precast	(✓)	900	( )	175'	( )	Dishwasher	( )
		1000	( )	200'	( )	Garbage Grdr.	( )
		1100	( )	225'	( )	Auto-Washer	( )
		1200	( )	250'	( )	Other	_____
		Other	_____	Other	_____		

NOTIFY HEALTH DEPARTMENT AT LEAST EIGHT HOURS BEFORE TANK IS TO BE INSPECTED.

Final Inspection 9 14 1959 Approved ( ) Disapproved ( )

Remarks Not for water - Soil ages well - 6 5 ft.

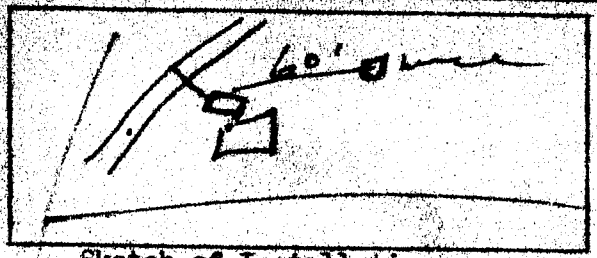

Sketch of Installation

Sanitarian