IREDELL COUNTY HEALTH DEPARTMENT

STATESVILLE 704-878-5305 (2) MOORESVILLE 704-664-5281

IMPROVEMENT PERMIT / AUTHORIZATION TO CONSTRUCT / OPERATION PERMIT / EXISTING SYSTEM INSPECTION

PERMIT# 119690 PIN# 4757-57-2350 DATE 4-22-04

OWNER OR CONTRACTOR JOHN BLACKWELDER PHONE: Business 704-902-3084 Home

ADDRESS 294 TURNERSBURG HWY STATESVILLE, NC 28677

LOCATION US 21 NORTH TL MAPLE CREEK DRIVE, LOT #4 ON RIGHT

SUBDIVISION MAPLE CREEK BLOCK / SECTION I LOT 4 LOT AREA 1.438 ACRES SITE CLASS. PS DESIGN FLOW 480 L.T.A.R. 0.30 GPD/FT²

Septic Tank: 1000 Gallons; STB 1012 Date 12-31-04

Pump Tank: ____ Gallons; PT ____ Date ____

Pump Make: ____ Model ____ Serial No. ____

Nitrification Field: No. Fields 1 Square Feet EQ. TO 1600 Linear Feet 400

No. Lines FOUR Trench Width 36" Max Trench Bottom Depth 36" Gravel Depth N/A

☑ New System ☐ Repair System Type: I, II, III, IV, V, VI

System Description: 25% REDUCTION, GRAVITY

Repair System Description: 50% REDUCTION, PUMP

Maintenance Agreement Required: ☐ Yes ☑ No

☑ House/Mod. Home No. Bedrooms 4

☐ Mobile Home No. Bathrooms 2½

☐ Business No. Employees ____

☐ Other ____


☐ Slab ☐ Crawl Space ☑ Basement w/plumbing ☐ Basement wo/plumbing

Water Supply: ☐ Individual ☑ Public ☐ Community


Comments:/Conditions: INSTALLER IS TO HALT CONSTRUCTION OF SYSTEM IF ANY EXISTING DRAINFIELD IS INTERSECTED DURING INSTALLATION (OLD NORRIS BLACKWELDER MHP)

Comments:/Conditions: SEPTIC TANK WITH MARKER INSTALLED USING "TUFTITE" FILTER

INITIAL SITE SKETCH

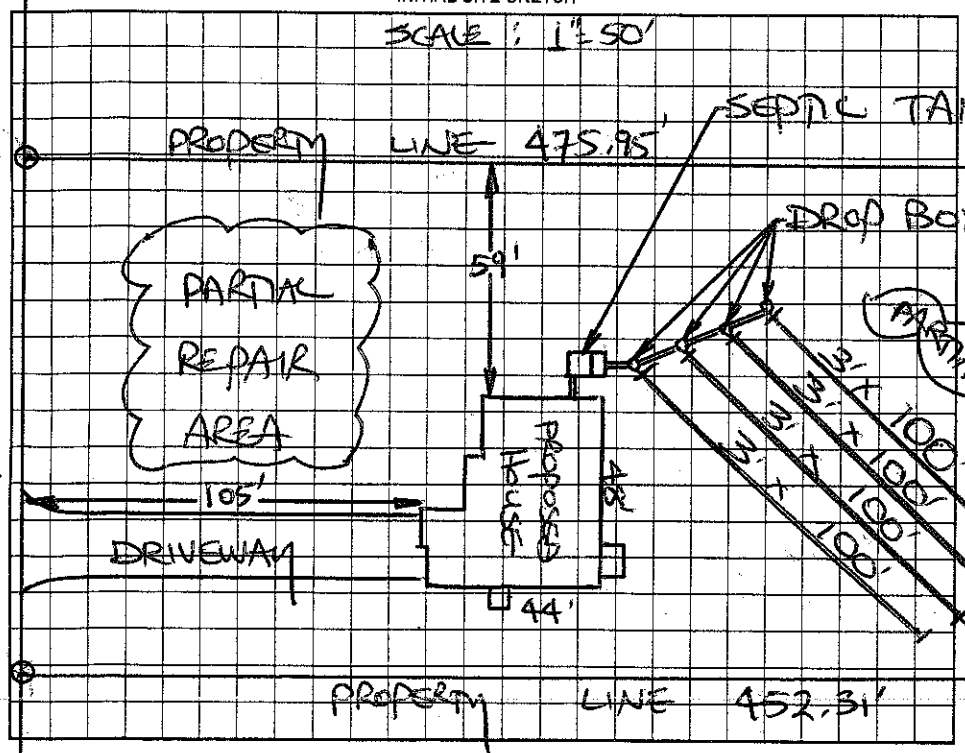

AS BUILT SKETCH

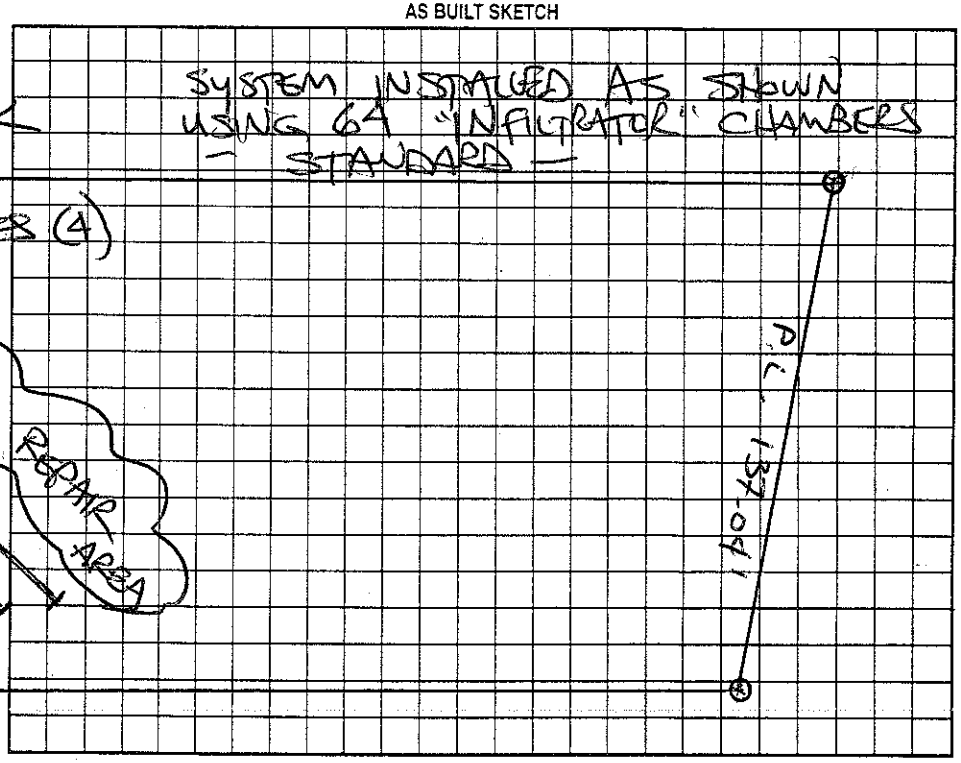

Permit can be suspended or revoked if any false information is supplied toward securing the permit/any unauthorized changes are made to the site/any unauthorized changes are made in the installation of the system. Improvement Permit with plat valid without expiration. Improvement Permit with site plan valid for sixty months. Authorization to Construct is valid for a period equal to that of Improvement Permit – not to exceed sixty months.

Signed: X Dan Osborne date 4-22-04 Installed by: CRAIG THOMPSON

Improvement Permit by: STEVE HEDRICK date 4-22-04 Operation Permit by: STEVE HEDRICK date 6-24-05

Authorization to Construct by: STEVE HEDRICK date 4-22-04 Existing System Inspection by: ____ date ____

HEALTH DEPT. COPY: WHITE OWNER COPY (FINAL): YELLOW OWNER COPY (INITIAL): PINK