2:00.

IREDELL COUNTY HEALTH DEPARTMENT

Statesville Office (704) 878-5305 Mooresville Office (704) 660-3625 PERMIT # 224845

IMPROVEMENT PERMIT / AUTHORIZATION TO CONSTRUCT / OPERATION PERMIT / EXISTING SYSTEM

PIN # 4757573679

APPLICANT: Jeff Miller APPLICANT ADDRESS: 127 Four Winds Dr Statesville NC 28625

SITE ADDRESS: 238 Maple Creek Dr Statesville NC PHONE: 704-775-6652 ALT. PHONE: N/A

SITE DIRECTIONS: 77 N T/R 21 N T/L Maple Creek Lot on right

SUBDIVISION: Maple Creek SECTION: 51 LOT # 7 LOT AREA: 1.650ac DESIGN FLOW: 360 L.T.A.R.: 0.3

Septic Tank 1000 (gal) STB 1012 Date 7/17/17
Pump Tank (gal) PT Date
Pump Make Model Serial #
Nitrification Fields 1 # Lines 4 Linear Ft: 300
Trench Width 36" Max. Trench Bottom Depth 36" Gravel Depth N/A


☒ New System ☐ Repair ☐ Expansion System Type: I II ☒ III IV V VI
System Description: 25% reduction
Repair System Description: 25% reduction
Maintenance Agreement Required: ☐ YES ☒ NO
☒ GRAVITY ☐ PRESSURE

☒ Residence No. Bedrooms 3
☐ Business No. Persons 6
☐ Other No. Employees
☐ Slab ☒ Crawl Space
☐ Basement w/plumbing ☐ Basement w/o plumbing

Water Supply: ☐ Private ☒ Public ☐ Community


Comments / Conditions: Install 25% reduction on Contour with Serial distribution

INITIAL SITE SKETCH

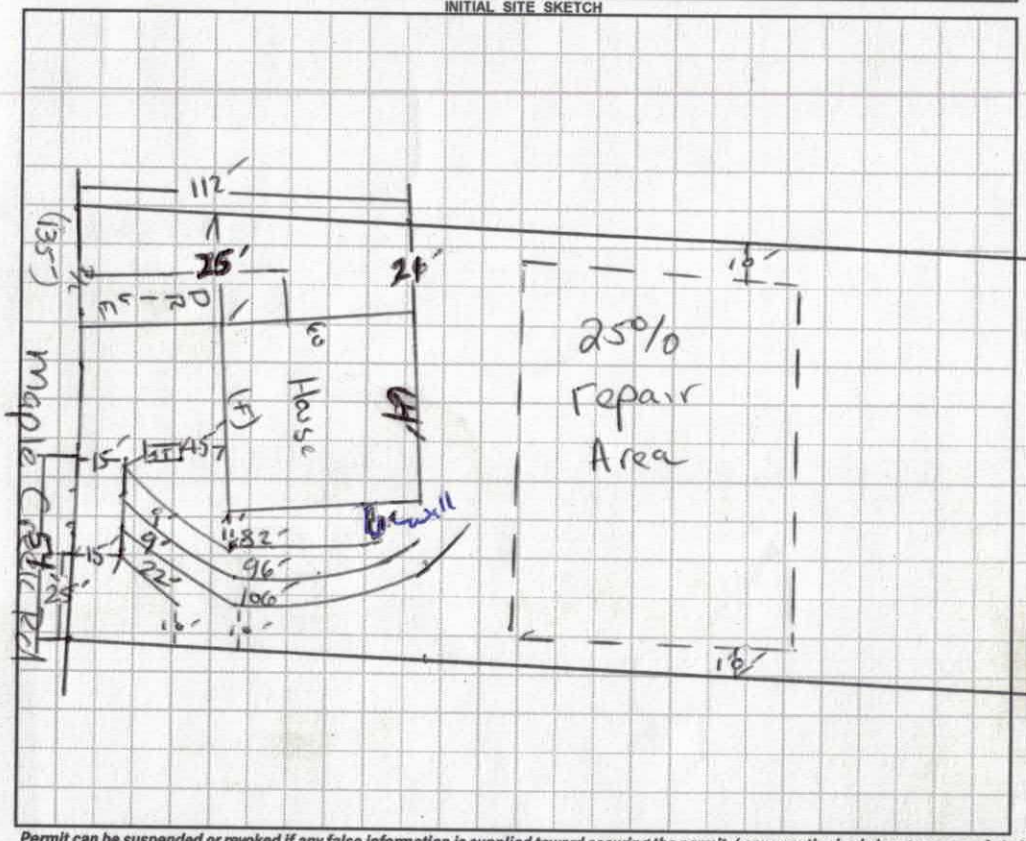

AS BUILT SKETCH

1" = 60

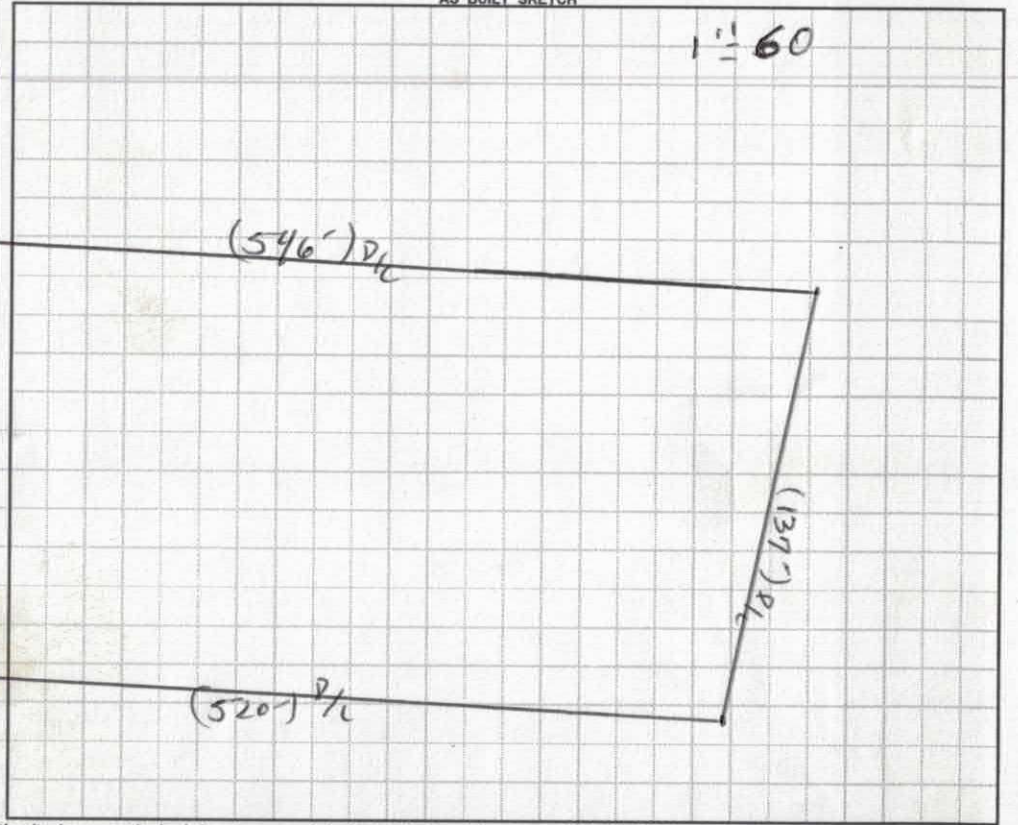

Permit can be suspended or revoked if any false information is supplied toward securing the permit / any unauthorized changes are made to the site / any unauthorized changes are made in the installation of the system. **CONTACT A LOCATOR SERVICE PRIOR TO ANY EXCAVATION**

☐ **IMPROVEMENT PERMIT** *with plat valid without expiration.* ☒ **IMPROVEMENT PERMIT** *with site plan valid for 60 mos.* ☒ **AUTHORIZATION TO CONSTRUCT** *valid for period equal to IMPROVEMENT PERMIT--not to exceed 60 mo.*

Owner / Applicant Signature: Date: 03/06/17 Installed by: Steve Jordan - Piedmont Backhoe

IMPROVEMENT PERMIT by: Date: 03/03/17 OPERATION PERMIT by: Benjamin A. Bottino Date:

AUTHORIZATION TO CONSTRUCT by: Date: 03/03/17 Existing System Inspected by: Date:

Health Dept. Copy - WHITE Applicant (Final Approval) - YELLOW Applicant (Conditional Approval) - PINK

DEPARTMENT OF HEALTH AND HUMAN SERVICES
DIVISION OF PUBLIC HEALTH, ENVIRONMENTAL HEALTH SECTION
ON-SITE WATER PROTECTION BRANCH

Sheet 1 of 7
PROPERTY ID #: 4757 57 7679
COUNTY: Iredell

SOIL/SITE EVALUATION
for ON-SITE WASTEWATER SYSTEM
(Complete all fields in full)

OWNER: Jeff Miller
ADDRESS: 238 maple Creek
PROPOSED FACILITY: SFD
PROPOSED DESIGN FLOW (.1949): 360
LOCATION OF SITE: 77 to 21 to maple Creek
APPLICATION DATE: 2-7-17
DATE EVALUATED: 2-28-17
PROPERTY SIZE: 1.65 ac
PROPERTY RECORDED: Yes
WATER SUPPLY: ☐ Private ☑ Public ☐ Well ☐ Spring ☐ Other W/A
EVALUATION METHOD: ☑ Auger Boring ☐ Pit ☐ Cut
TYPE OF WASTEWATER: ☑ Sewage ☐ Industrial Process ☐ Mixed

PROFILE #	.1940 LANDSCAPE POSITION/ SLOPE %	HORIZON DEPTH (IN.)	SOIL MORPHOLOGY (.1941) .1941 STRUCTURE/ TEXTURE	SOIL MORPHOLOGY (.1941) .1941 CONSISTENCE/ MINERALOGY	OTHER PROFILE FACTORS .1942 SOIL WETNESS/ COLOR	.1943 SOIL DEPTH	.1956 SAPRO CLASS	.1944 RESTR HORIZ	PROFILE CLASS & LTAR
1	L 5%	0-5	SBlG SCL	fr SE	PS	PS	34"	W/A	PS .3
		5-16	SBlC C	fi SE					
		16-34	WABK BC	fi/fr SE					
		34-46	Mass Saprl	fr W/A					
2	L 5%	0-6	6r SCL	fi SE	PS	PS	W/A	W/A	PS .3
		6-35	SBlC C	fi SE					
		35-46	WSBK BC	fi/fr SE					
3	L 6%	0-4	6r SCL	fr SE	PS	PS	W/A	W/A	PS .3
		4-24	SBlC C	fi SE					
		24-46	WSBK BC	fi/fr SE					
4	10%	0-6	6r SCL	fr SE	PS	PS	36"	W/A	PS .3
		8-16	SBlC C	fi SE					
		16-36	WSBK BC	fi/fr SE					
		36-48	Mass Saprl	fr W/A					

DESCRIPTION	INITIAL SYSTEM	REPAIR SYSTEM
Available Space (.1945)	PS	PS
System Type(s)	III	III
Site LTAR	.3	.3

OTHER FACTORS (.1946): PS
SITE CLASSIFICATION (.1948): PS
EVALUATED BY: H. Snow
OTHER(S) PRESENT:

COMMENTS: #5 0-6 6r SCL fr SE
6-24 SBlC C fi SE
24-46 WSBK BC fi/fr SE

LEGEND

use the following standard abbreviations

LANDSCAPE POSITION	GROUP	SOIL TEXTURE	CONVENTIONAL .1955 LTAR*	LPP .1957 LTAR*	MINERALOGY/ CONSISTENCE	STRUCTURE
CC (Concave Slope) CV (Convex Slope) D (Drainage Way) DS (Debris Slump) FP (Flood Plain) FS (Foot Slope) H (Head Slope) L (Linear Slope) N (Nose Slope) R (Ridge) S (Shoulder Slope) T (Terrace)	I	S (Sand) LS (Loamy Sand)	1.2 - 0.8	0.6 - 0.4	SEXP (Slightly Expansive) EXP (Expansive)	G (Single Grain) M (Massive) CR (Crumb) GR (Granular) SBK (Subangular Blocky) ABK (Angular Blocky) PL (Platy) PR (Prismatic)
	II	SL (Sandy Loam) L (Loam)	0.8 - 0.6	0.4 - 0.3		
	III	Si (Silt) SiCL (Silty Clay Loam) CL (Clay Loam) SCL (Sandy Clay Loam) SiL (Silt Loam)	0.6 - 0.3	0.3 - 0.15		
	IV	SC (Sandy Clay) SiC (Silty Clay) C (Clay) O (Organic)	0.4 - 0.1 None	0.2 - 0.05 None	**MOIST** VFR (Very Friable) FR (Friable) FI (Firm) VFI (Very Firm v. Very Sticky) EFI (Extremely Firm)	**WET** NS (Non-sticky) SS (Slightly Sticky) S (Sticky) VS (Very Sticky) NP (Non-plastic) SP (Slightly Plastic) P (Plastic) VP (Very Plastic)

*Adjust LTAR due to depth, consistence, structure, soil wetness, landscape, position, wastewater flow and quality.


NOTES

HORIZON DEPTH	In inches below natural soil surface
DEPTH OF FILL	In inches from land surface
RESTRICTIVE HORIZON	Thickness and depth from land surface
SAPROLITE	S(suitable) or U(unsuitable)
SOIL WETNESS	Inches from land surface to free water or inches from land surface to soil colors with chroma 2 or less - record Munsell color chip designation
CLASSIFICATION	S (Suitable), PS (Provisionally Suitable), or U (Unsuitable)

Evaluation of saprolite shall be by pits.

Long-term Acceptance Rate (LTAR): gal/day/ft^2

Show profile locations and other site features (dimensions, reference or benchmark, and North).

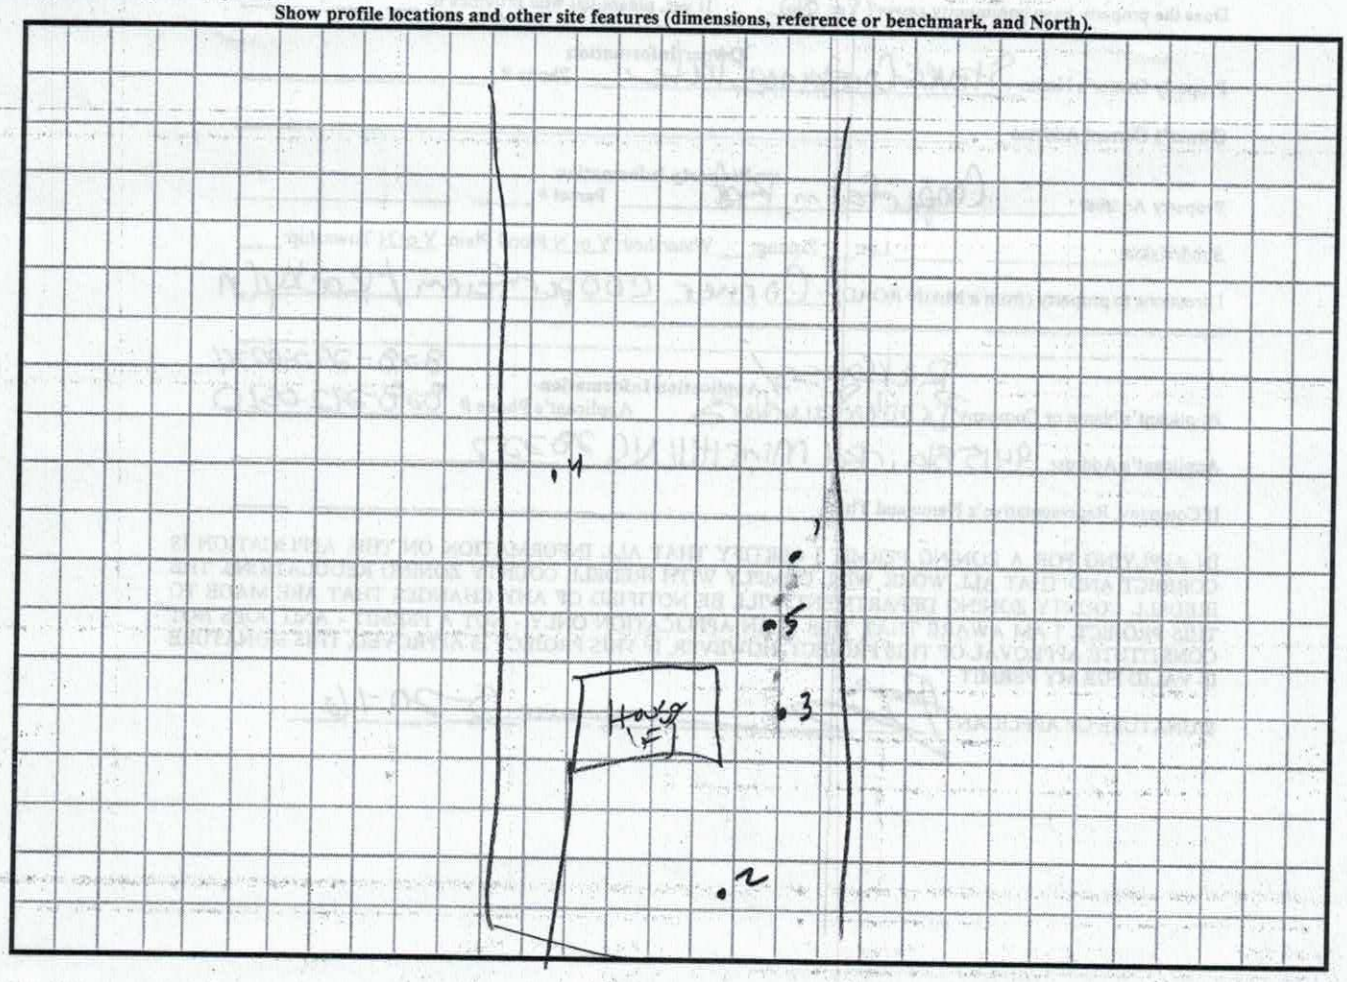

IREDELL COUNTY HEALTH DEPARTMENT *ENVIRONMENTAL HEALTH DIVISION*

(THE ABOVE PERMIT DOCUMENTS WILL BECOME INVALID IF INFORMATION PROVIDED ON THIS APPLICATION IS FALSIFIED OR CHANGED, OR IF THE SITE IS ALTERED. THE IMPROVEMENT PERMIT IS VALID FOR EITHER 60 MONTHS OR WITHOUT EXPIRATION DEPENDING UPON DOCUMENTATION SUBMITTED - APPLICATION WITH SITE PLAN 60 MONTHS, APPLICATION WITH COMPLETE, SCALED PLAT WITHOUT EXPIRATION. SEE 15A NCAC 18A .1937(f) FOR DETAILS)

1. APPLICATION FOR: ___Improvement Permit _X_ Authorization To Construct ___ Existing System Inspection

2. Page 2: *Site Plan Worksheet* Form MUST Accompany This Application
   The following optional attachments may also be submitted: ___Survey Plat, Scaled no more than 1 Inch = 60 Feet
   Place check ( ) beside whichever is submitted if applicable ___Custom Site Plan, Scaled no more than 1 Inch = 60 Feet

3. Applicant Information:

Applicant Name	Mailing Address	Home Phone #	Alternate Phone #
JEFFREY MILLER	127 FOUR WINDS DR 28625	704-775-6652	
Owner Name	**Mailing Address**	**Home Phone #**	**Alternate Phone #**
JEFFREY & LORI MILLER	SAME	704-775-6652	

4. Property Information:

Street Address	Subdivision Name	Section/Phase and Lot Number
238 MAPLE CREEK RD	MAPLE CREEK	

Driving Directions: I-77 NORTH TO EXIT 54. TURN RIGHT ON 21. GO 1½ MILES MAPLE CREEK RD ON LEFT. LOT ON NORTH (RIGHT SIDE, PAST RAVENSCREST)

5. RESIDENTIAL Site Development Information: *(Check or Complete ALL that apply)*

(X) New, Single Family Residence — Maximum Number of Bedrooms 3 — ( ) Crawl Space Foundation?
( ) New, Multi-Family Residence — Maximum Number of Occupants 6 — (X) Concrete Slab Foundation?
( ) Expansion of Existing Septic System — If Expansion, Current Number of Bedrooms ___ — ( ) Basement w/Plumbing?
(X) Repair To Failing Septic System due to _____ — ( ) Basement w/out Plumbing?
( ) Other _____

IF Non-Residential Site Development: Type of Business _____
Square Footage of Building _____
Maximum Number of Employees _____
Maximum Number of Seats _____

6. Proposed Water Supply:

( ) New Well ( ) Existing Well ( ) Community Well ( ) City Water (X) Other Public Water

7. Desired Septic System Type: *(You may rank in order of preference, if any)* ( ) EXISTING SYSTEM installed _____ *Year*

( ) Alternative (1) Conventional ( ) Innovative ( ) Modified Conventional ( ) Other_____

8. Please Answer The Following ( ) Yes (X) No Does the site contain any jurisdictional wetlands?
   To The Best of Your Ability: ( ) Yes (X) No Is any non-domestic sewage (i.e. industry) to be generated?
   ( ) Yes (X) No Is the site subject to approval by any other public agency?

I have read this application and certify that the information provided herein is true, complete, and correct. Authorized county and state officials are granted right of entry to conduct necessary inspections to determine compliance with applicable laws and rules. I understand that I am solely responsible for the proper identification and labeling of all property lines and corners and making the site accessible so that a complete site evaluation can be performed.

9. Signature: _____ 2/7/17
   Property owner or owner's legal representative signature (SIGNATURE REQUIRED) DATE

IREDELL COUNTY HEALTH DEPARTMENT *ENVIRONMENTAL HEALTH DIVISION*:

SITE PLAN WORKSHEET

SEE THE "SAMPLE SITE PLAN" BELOW. ***INCOMPLETE SITE PLANS WILL BE RETURNED TO YOU FOR COMPLETION AND MAY RESULT IN A DELAY IN THE ISSUANCE OF YOUR SEPTIC SYSTEM PERMIT!!!***

Place an (X) beside each item as you complete the site plan:

✓ Property Line measurements are clearly identified...

✓ All proposed structures are indicated...

SHOW: proposed house or business footprint, wells, water lines, patios, pools and decks, and any other item that will occupy space on the site

✓ Front and side setbacks from property line...

✓ Area you prefer your septic system to be placed...

✓ Preferred driveway location and configuration, preferred well location...


✓ North arrow, or other sufficient indicator of direction...

Circle N/A on the following if appropriate:

_____ Location of septic systems and wells within 100' of your property... N/A

_____ Location of easements and rights of ways on your property... N/A


_____ Location of any designated wetlands on the property... N/A

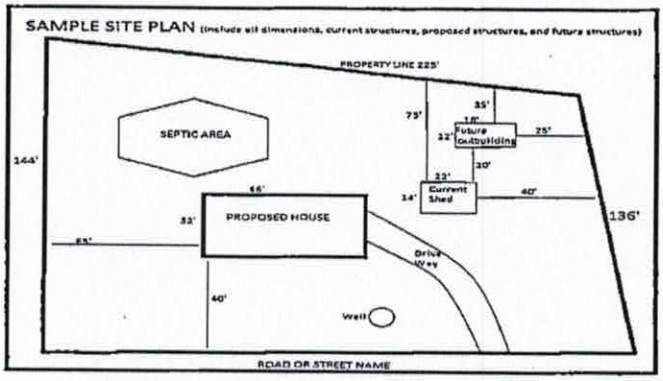

New layout

NORTH

USE THIS SPACE TO DRAW YOUR SITE PLAN

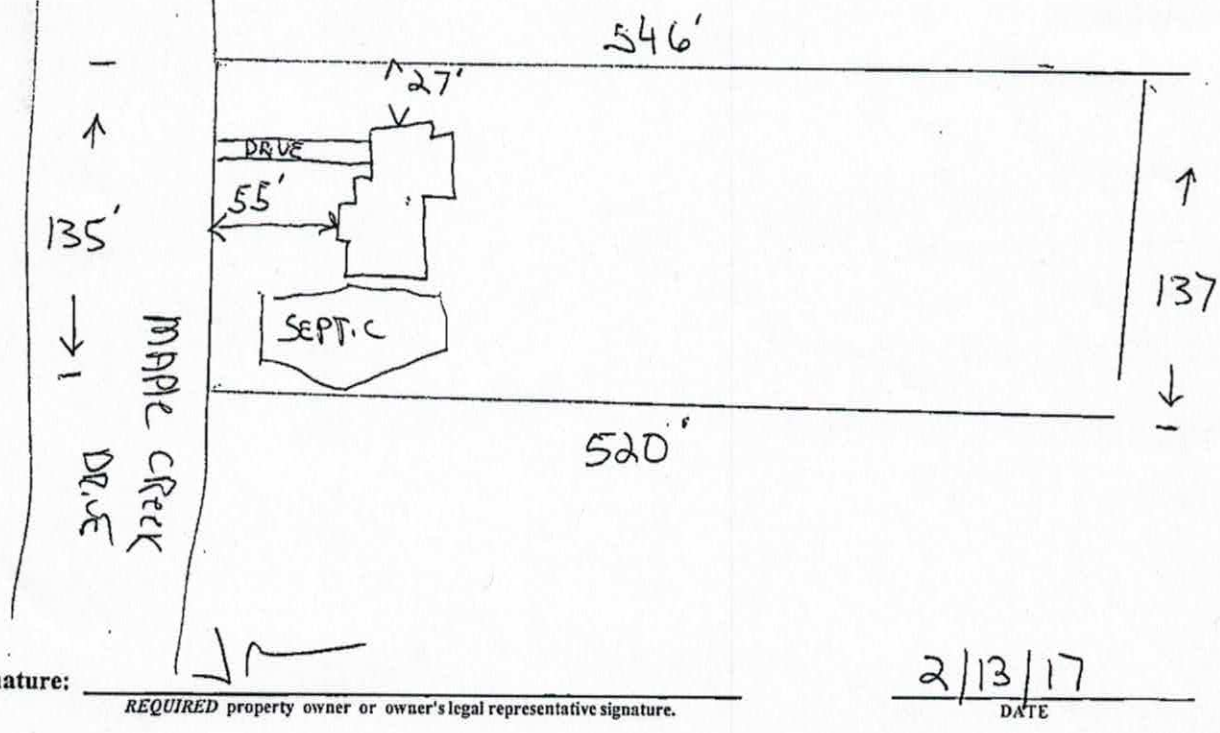


Signature: _____

REQUIRED property owner or owner's legal representative signature.

2/13/17

DATE


JEFF MILLER
TOP FLOOR

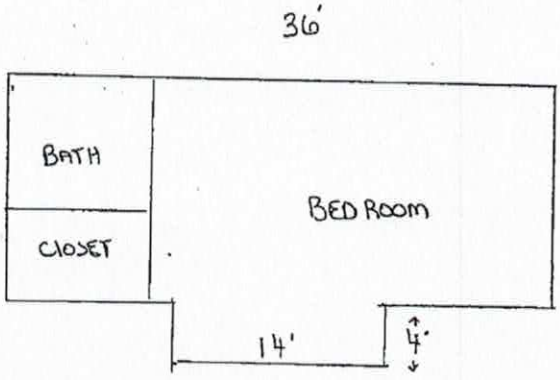



Acknowledgement
Plans Submittal ONLY
Date 02/16/17
Date 03/03/17

JEFFREY MILLER
MAIN FLOOR

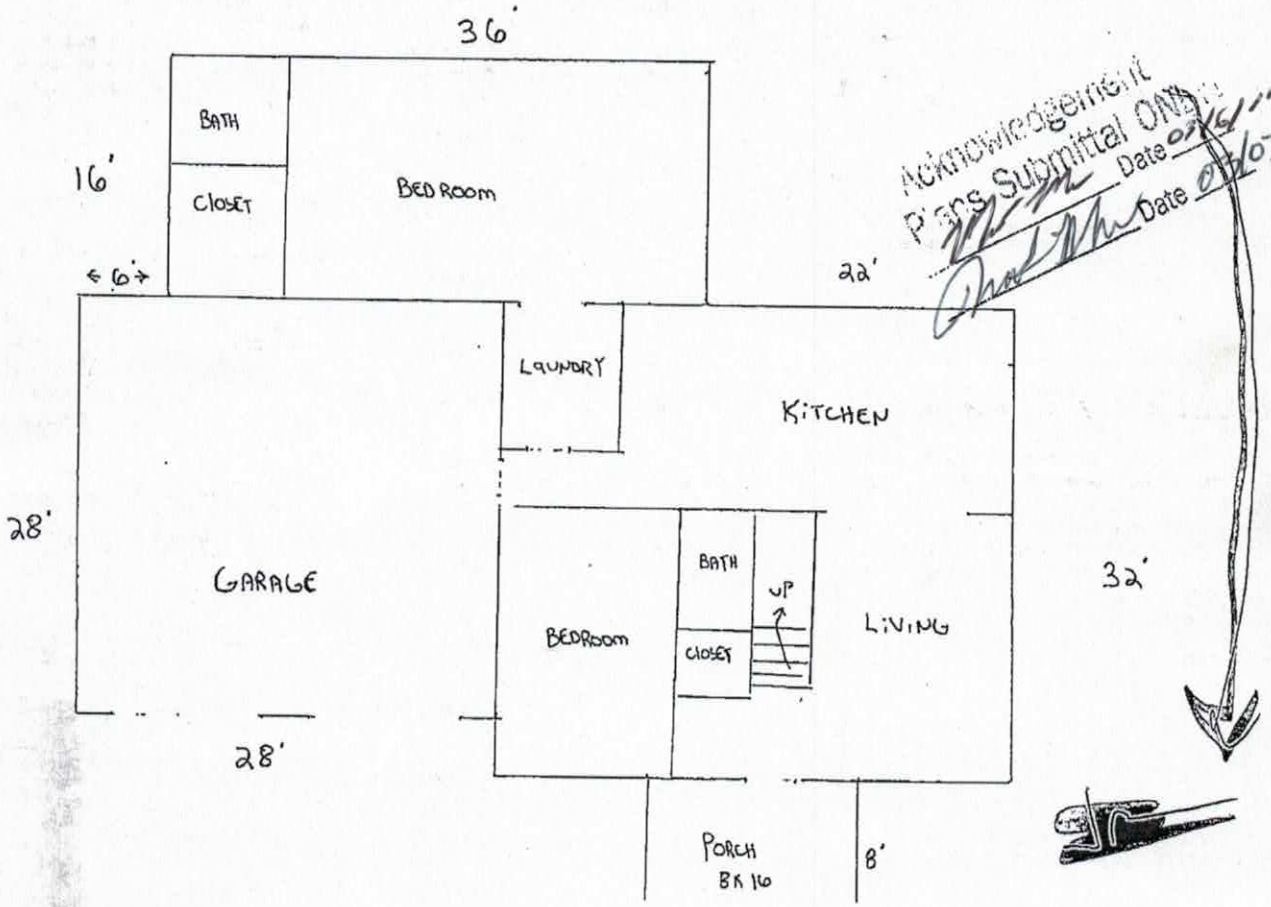

Acknowledgement
Plans Submittal ONLY

IREDELL COUNTY

PO Box 788
349 North Center St.
Statesville, NC 28677

APPLICATION NUMBER
224845
Issue Date: 02/08/2017

ZONING PERMIT
Open Space

Parcel Number	Street Address	Jurisdiction
4757573679.000	238 MAPLE CREEK DRIVE, STATESVILLE, NC	IREDELL COUNTY

Owner Information	Applicant Information
Owner: MILLER, JEFFREY E. MILLER, LORI A.	Applicant: JEFFREY, MILLER E.
Address: STATESVILLE, NC 28625	Address: 127 FOUR WINDS DR STATESVILLE, NC 28625
Phone: - -	Phone: 704-775-6652

Use Requested	Zone Code
	RA

Lot Acreage	F Setback	B Setback	L Setback	R Setback	Watershed	Flood Zone
1.650	35.00	35.00	15.00	15.00	NOT	X

Remarks:

The applicant certifies that there are no deed restrictions, contractual agreements or governmental regulations of any kind that interfere with or prohibit the use of the property or the use for which this permit is requested. The applicant further acknowledges that enforcement of deed restrictions, plat conditions and other contractual agreements will not be undertaken by Iredell County and is the sole responsibility of the affected parties.

Applicant: _____ Date: _____

Permit Number	92729	TOTAL FEES:	$ 77.25