IREDELL COUNTY HEALTH DEPARTMENT

STATESVILLE 704-878-5305 (C1) MOORESVILLE 704-664-5281

IMPROVEMENT PERMIT / AUTHORIZATION TO CONSTRUCT / OPERATION PERMIT / EXISTING SYSTEM INSPECTION

(2)

PERMIT# 119159 PIN# 4757-58-2014 DATE 3-16-04

OWNER OR CONTRACTOR TERRANCE M. HAMBY PHONE: Business Home 704-546-5034

ADDRESS 651 RABBIT HWY, HARMONY, NC 28634

LOCATION US 21 NORTH, TL, MAPLE CREEK, DRIVE, LOT AT END ON RIGHT

SUBDIVISION MAPLE CREEK BLOCK / SECTION I LOT 9 LOT AREA 0.690 ACRE SITE CLASS. PS DESIGN FLOW 360 L.T.A.R. 0.25 GPD/FT²

CUL-DE-SAC

FOUR WINDS DRIVE

Septic Tank: 1000 Gallons; STB 1000 Date 7-4-04

Pump Tank: Gallons; PT Date

Pump Make: Model Serial No.

Nitrification Field: No Fields 1 Square Feet 1440 Linear Feet 480

No Lines FIVE Trench Width 36" Max Trench Bottom Depth 36" Gravel Depth 12"

☑ New System ☐ Repair System Type: I, II, III, IV, V, VI

System Description: CONVENTIONAL, GRAVITY

Repair System Description: CONVENTIONAL, PUMP

Maintenance Agreement Required: ☐ Yes ☑ No

☑ House/Mod. Home No. Bedrooms 3

☐ Mobile Home No. Bathrooms 2

☐ Business No. Employees

☐ Other


☐ Slab ☑ Crawl Space ☐ Basement w/plumbing ☐ Basement wo/plumbing

Water Supply: ☐ Individual ☑ Public ☐ Community


Comments:/Conditions: (3) REMOVE EXISTING FIELD TERRACE (2) INSTALL LINES ON CONTOUR AS FLAGGED

Comments:/Conditions: SEPTIC TANK WITH MARKED INSTALLED USING "ZABEL" FILTER

INITIAL SITE SKETCH

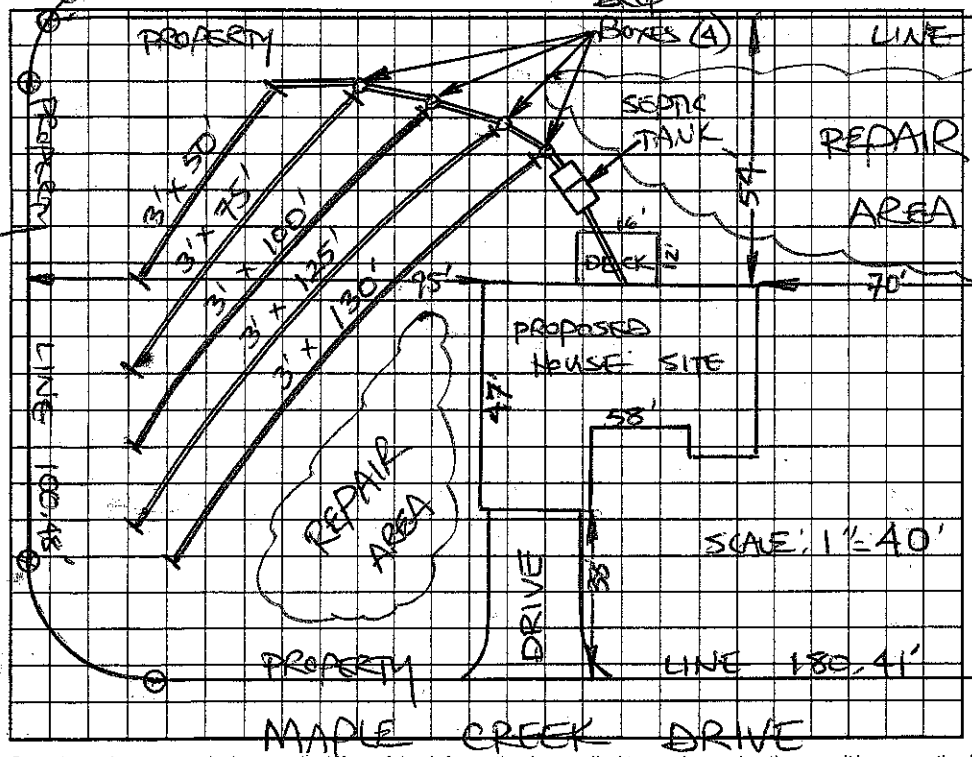

AS BUILT SKETCH

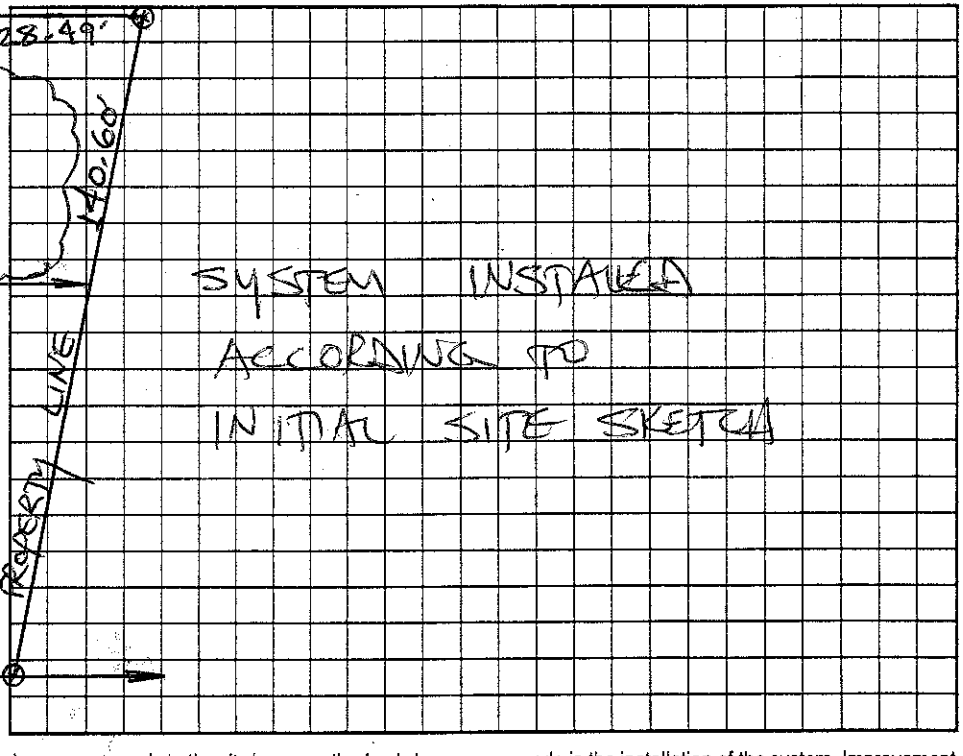

Permit can be suspended or revoked if any false information is supplied toward securing the permit/any unauthorized changes are made to the site/any unauthorized changes are made in the installation of the system. Improvement Permit with plat valid without expiration. Improvement Permit with site plan valid for sixty months. Authorization to Construct is valid for a period equal to that of Improvement Permit – not to exceed sixty months.

Signed: Terrance Hamby date 3-16-04 Installed by: TOMMY COTHREN

Improvement Permit by: STEVE HEDRICK date 3-16-04 Operation Permit by: STEVE HEDRICK date 9-2-04

Authorization to Construct by: STEVE HEDRICK date 3-16-04 Existing System Inspection by: date

HEALTH DEPT. COPY: WHITE OWNER COPY (FINAL): YELLOW OWNER COPY (INITIAL): PINK