IREDELL COUNTY HEALTH DEPARTMENT

STATESVILLE 704-878-5305 MOORESVILLE 704-664-5281

IMPROVEMENT PERMIT / AUTHORIZATION TO CONSTRUCT / OPERATION PERMIT / EXISTING SYSTEM INSPECTION

PERMIT# 091569 PIN# 4757 47 2480 (PT) DATE 8-29-00

OWNER OR CONTRACTOR JOHN'S WELDING PHONE: Business 873-7805 Home

ADDRESS 1516 MOCKSVILLE HWY, STATESVILLE NC 28625

LOCATION US 21 NORTH, TL MAPLE CREEK TR FOUR WINDS DR, LOT ON LEFT AT CUL-DE-SAC

SUBDIVISION MAPLE CREEK BLOCK / SECTION I LOT 13 LOT AREA 0.804 AC SITE CLASS PS DESIGN FLOW 360 L.T.A.R. 0.30 GPD/FT²

Septic Tank: 1000 Gallons; STB 1012 Date 9-7-00
Pump Tank: Gallons; PT Date
Pump Make: Model Serial No.
Nitrification Field: No Fields 1 Square Feet 1200 Linear Feet 400
No Lines FOUR Trench Width 36" Max Trench Bottom Depth 30" Gravel Depth 12"

☑ New System ☐ Repair System Type: I. II. IV. V. VI
System Description: CONVENTIONAL GRAVITY
Repair System Description: CONV. GRAVITY
Maintenance Agreement Required: ☐ Yes ☑ No
☐ Slab ☑ Crawl Space ☐ Basement w/plumbing ☐ Basement wo/plumbing


☑ House/Mod. Home No. Bedrooms 3
☐ Mobile Home No. Bathrooms 2
☐ Business No. Employees
☐ Other

Water Supply: ☐ Individual ☑ Public ☐ Community

Comments/Conditions: INSTALL SUBSURFACE INTERCEPT DRAINAGE DITCH AT LOCATION SHOWN BEGINNING 42" DEEP OUT TO DAYLIGHT

Comments/Conditions. SEPTIC TANK W/ RISERS INSTALLED USING "POLLOK" FILTER

SCALE: 1" = 50' INITIAL SITE SKETCH

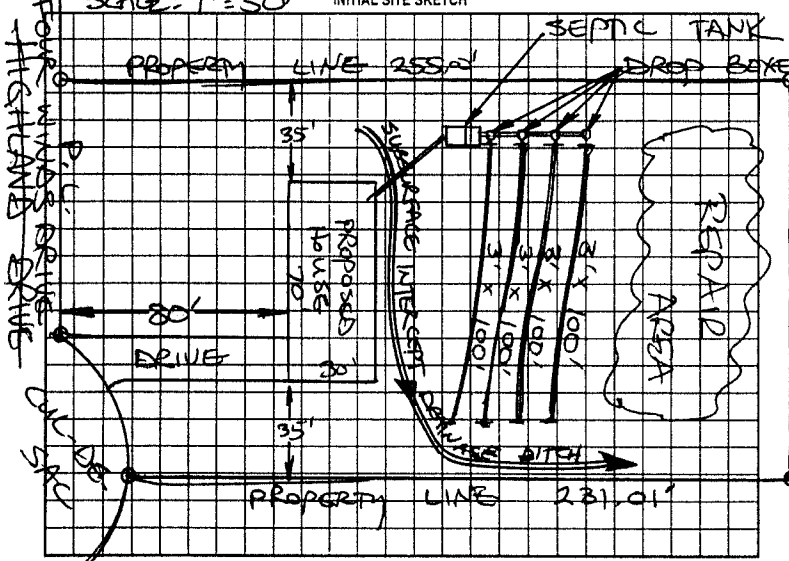

AS BUILT SKETCH

SYSTEM INSTALLED ACCORDING TO INITIAL SITE SKETCH

Permit can be suspended or revoked if any false information is supplied toward securing the permit/any unauthorized changes are made to the site/any unauthorized changes are made in the installation of the system. Improvement Permit with plat valid without expiration. Improvement Permit with site plan valid for sixty months. Authorization to Construct is valid for a period equal to that of Improvement Permit - not to exceed sixty months.

Signed: Mary Mountford date 9-5-00
Improvement Permit by: STEVE HEDRICK date 8-29-00
Authorization to Construct by: STEVE HEDRICK date 8-29-00

Installed by: STEVE JORDAN
Operation Permit by: STEVE HEDRICK date 12-13-00
Existing System Inspection by: date

HEALTH DEPT. COPY WHITE OWNER COPY (FINAL) YELLOW OWNER COPY (INITIAL) PINK