3.008

IREDELL COUNTY HEALTH DEPARTMENT

STATESVILLE 704-878-5305 MOORESVILLE 704-664-5281

IMPROVEMENT PERMIT / AUTHORIZATION TO CONSTRUCT / OPERATION PERMIT / EXISTING SYSTEM INSPECTION

PERMIT # Repair PIN # 4757-65-6087 DATE March 1, 2012

OWNER or APPLICANT Duane Becker PHONE: Business Home:

OWNER or APPLICANT ADDRESS 1362 Turnersburg Hwy Statesville

LOCATION / DIRECTIONS US 21 N on Right past Maple Creek Rd.

SUBDIVISION BLOCK / SECTION LOT # LOT AREA 8 Ac DESIGN FLOW 460 gpd L.T.A.R.

Septic Tank 1000 Gallons: STB 760 Date 7-5-11

Pump Tank Gallons: P T Date

Pump Make Model Serial #

Nitrification Field No Fields EX No Lines Linear Feet

Trench Width EX Max. Trench Bottom Depth Gravel Depth

☐ New System ☒ Repair ☐ Expansion System Type I II III IV V VI

System Description: Tank replacement only

Repair System Description:

Maintenance Agreement Required ☐ YES ☐ NO

☒ GRAVITY ☐ PRESSURE

☒ Residence No. Bedrooms 4

☐ Business No. Persons

☐ Other No. Employees

☐ Slab ☒ Crawl Space


☐ Basement w/plumbing ☐ Basement w/o plumbing

Water Supply: ☐ Private ☒ Public ☐ Community

Comments / Conditions: 1000 gal minimum tank size for replacement

Comments / Conditions

INITIAL SITE SKETCH

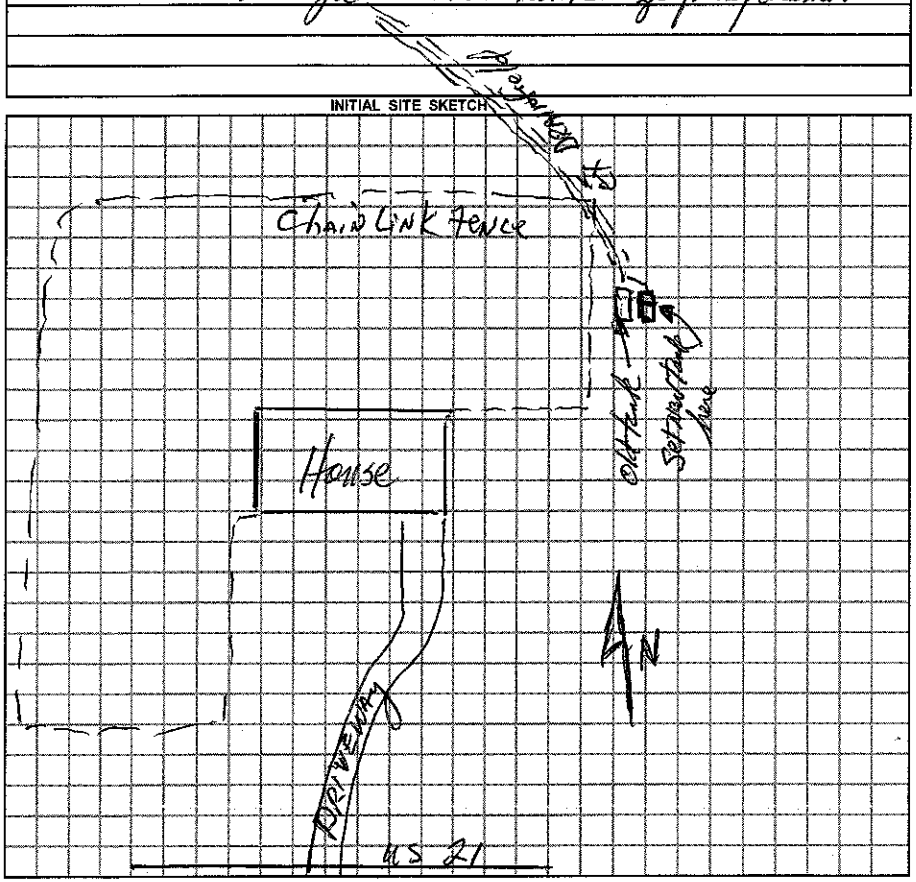

AS BUILT SKETCH

Permit can be suspended or revoked if any false information is supplied toward securing the permit / any unauthorized changes are made to the site / any unauthorized changes are made in the installation of the system.

☐ *IMPROVEMENT PERMIT w / plat valid without expiration.* ☐ *IMPROVEMENT PERMIT w / site plan valid for 60 mos.* ☐ *AUTHORIZATION TO CONSTRUCT valid for period equal to IMPROVEMENT PERMIT-not to exceed 60 mo.*

Owner / Applicant Signature: Date 3-1-12

Improvement Permit by: Date 3-1-12

Authorzation to Construct by: Date 3-1-12

Installed by: Lentz Septic

Operation Permit by: Date: 3/5/12

Existing System Inspected by: Date:

YOU SHOULD CONTACT A LOCATOR SERVICE PRIOR TO ANY EXCAVATION.

WHITE COPY Environmental Health YELLOW COPY (Final) Owner / Applicant PINK COPY (Initial) Owner / Applicant