IREDELL COUNTY HEALTH DEPARTMENT

STATESVILLE 704-878-5305 MOORESVILLE 704-664-5281

IMPROVEMENT PERMIT / AUTHORIZATION TO CONSTRUCT / OPERATION PERMIT / EXISTING SYSTEM INSPECTION

PERMIT# PIN# DATE 11-1-99

OWNER OR CONTRACTOR David Benbow PHONE: Business Home 876 1901

ADDRESS 353 Baymount Dr. Statesville

LOCATION 21 N IRI Jane Sowers TL Country/Or TL Baymount Ini Pt

SUBDIVISION BLOCK / SECTION LOT LOT AREA acreage SITE CLASS PSI DESIGN FLOW 480 L.T.A.R. .3

Septic Tank: EX Gallons: STB Date

Pump Tank: Gallons: PT Date

Pump Make: Model Serial No

Nitrification Field: No Fields 7 Square Feet 1560 Linear Feet 520

No Lines 6 Trench Width 72" Max Trench Bottom Depth 36" Gravel Depth 18"

☐ New System ☑ Repair System Type: I (II) III IV V VI

System Description:

Repair System Description: Conv. Gravity

Maintenance Agreement Required: ☐ Yes ☑ No

☐ House/Mod. Home No. Bedrooms 4

☐ Mobile Home No. Bathrooms

☐ Business No. Employees


☐ Other

☐ Slab ☐ Crawl Space ☑ Basement w/plumbing ☐ Basement wo/plumbing

Water Supply: ☐ Individual ☑ Public ☐ Community


Comments/Conditions: Fence

INITIAL SITE SKETCH

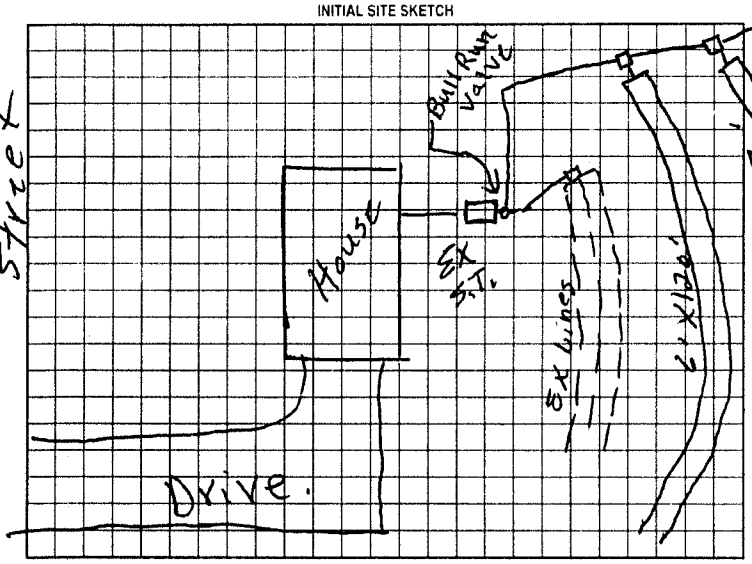

Comments/Conditions: New lines are on Number 1 on valve. use New lines For 1 year Then use Existing lines In Summer months To Rest New lines

AS BUILT SKETCH

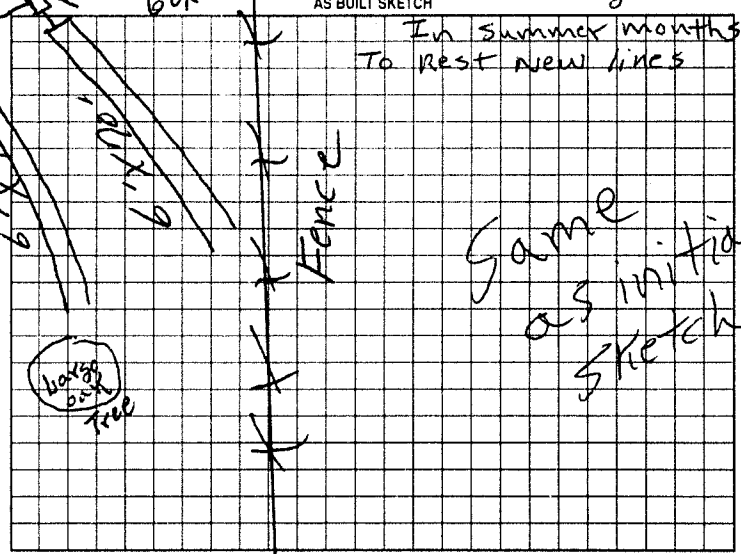

Permit can be suspended or revoked if any false information is supplied toward securing the permit/any unauthorized changes are made to the site/any unauthorized changes are made in the installation of the system. Improvement Permit with plat valid without expiration. Improvement Permit with site plan valid for sixty months. Authorization to Construct is valid for a period equal to that of Improvement Permit – not to exceed sixty months.

Signed: Anita D. Benbow date 11-1-99 Installed by: Barry Sigmon

Improvement Permit by: F.C. Moore date 11-1-99 Operation Permit by: F.C. Moore date 12-7-99

Authorization to Construct by: F.C. Moore date 11-1-99 Existing System Inspection by: date

HEALTH DEPT COPY WHITE OWNER COPY (FINAL) YELLOW OWNER COPY (INITIAL) PINK