IREDELL COUNTY HEALTH DEPARTMENT

STATESVILLE 704-878-5305 (a) MOORESVILLE 704-664-5281 (a)

IMPROVEMENT PERMIT / AUTHORIZATION TO CONSTRUCT / OPERATION PERMIT / EXISTING SYSTEM INSPECTION

PERMIT # 156182 PIN # 4757-70-8876 DATE

OWNER or APPLICANT Chris Hall PHONE: Business Home:

OWNER or APPLICANT ADDRESS 169 Burton Place Statesville NC 28625

LOCATION / DIRECTIONS 21N (R) Jane Sowers (R) onto Century Drive (L) Bayonet (R) Bayonet AC (R) Burton Pl (L)

SUBDIVISION BLOCK / SECTION LOT # LOT AREA 5.464 DESIGN FLOW L.T.A.R. EXIST

Septic Tank EXIST Gallons: STB EXIST Date EXIST

Pump Tank Gallons: P T Date

Pump Make Model Serial #

Nitrification Field No Fields No Lines Linear Feet EXIST

Trench Width EXIST Max. Trench Bottom Depth EXIST Gravel Depth N/A

~~New System~~ ☐ Repair ☐ Expansion System Type I II III IV V VI

System Description: 3570 Gravity

Repair System Description: 3570 Gravity

Maintenance Agreement Required ☐ YES ☐ NO

☐ GRAVITY ☐ PRESSURE

☑ Residence No. Bedrooms 6

☐ Business No. Persons

☐ Other No. Employees

☐ Slab ☐ Crawl Space

☐ Basement w/plumbing ☐ Basement w/o plumbing


Water Supply: ☐ Private ☑ Public ☐ Community

Comments / Conditions

Comments / Conditions


Existing System Check for prob

INITIAL SITE SKETCH

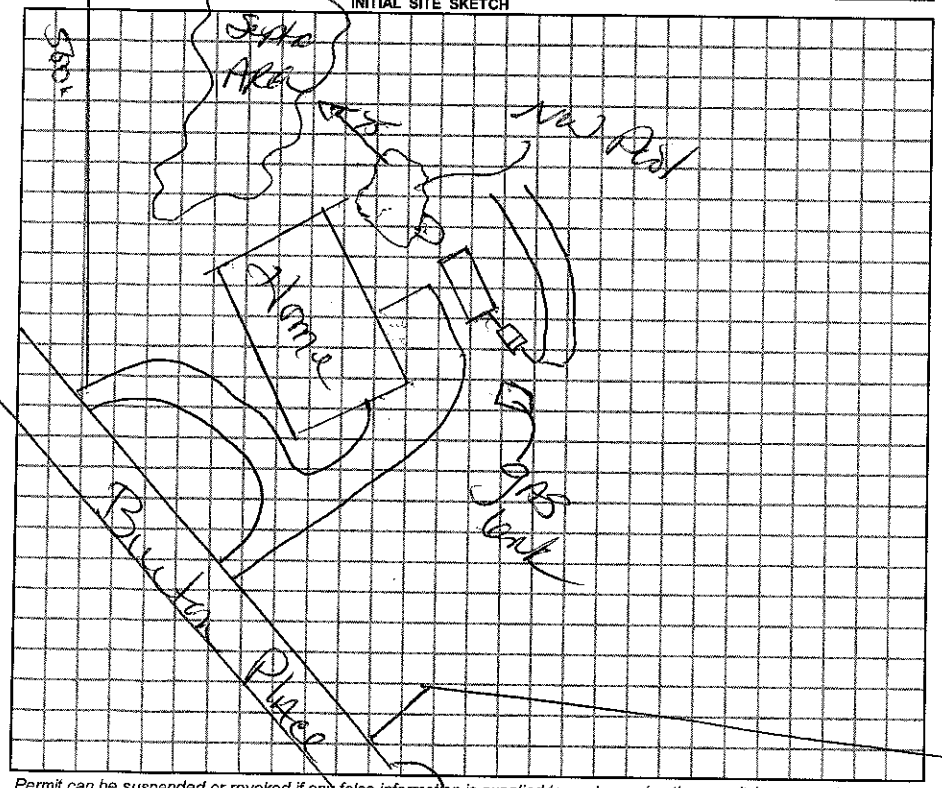

AS BUILT SKETCH

System is 50 → 75 away from new proposed Bank area

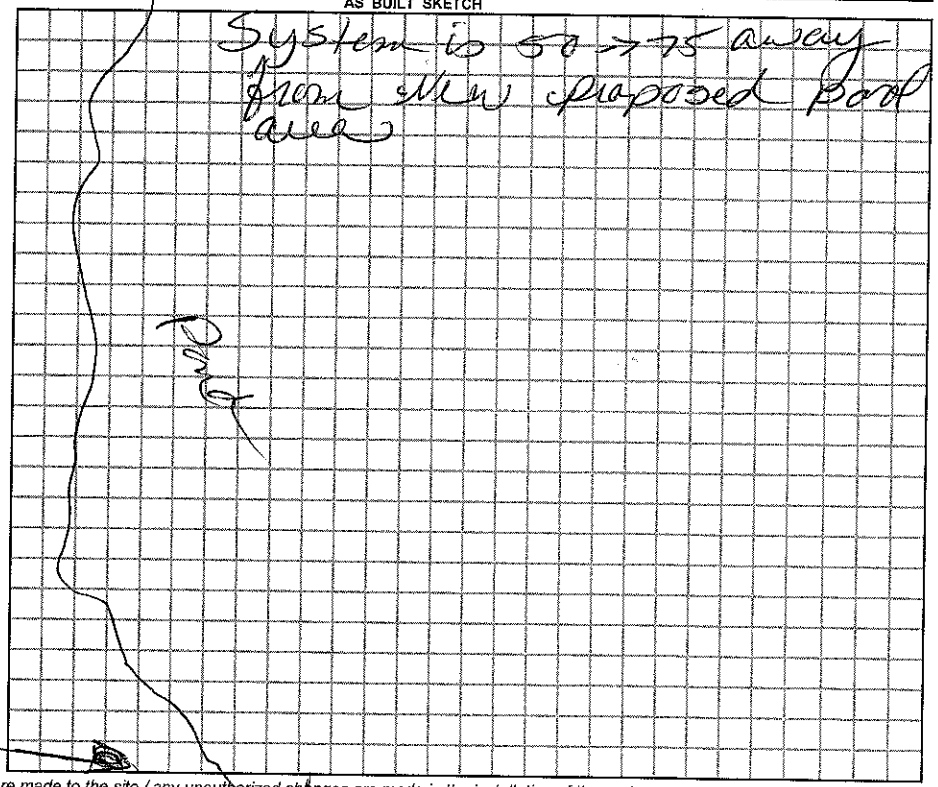

Permit can be suspended or revoked if any false information is supplied toward securing the permit / any unauthorized changes are made to the site / any unauthorized changes are made in the installation of the system.

☐ *IMPROVEMENT PERMIT w / plat valid without expiration* ☐ *IMPROVEMENT PERMIT w / site plan valid for 60 mos.* ☐ *AUTHORIZATION TO CONSTRUCT valid for period equal to IMPROVEMENT PERMIT-not to exceed 60 mo.*

Owner / Applicant Signature: Date

Improvement Permit by: Date 4-24-09

Authorization to Construct by: Date 4/24/09

Installed by:

Operation Permit by: Date: 4

Existing System Inspected by: Date: 4-24-09

YOU SHOULD CONTACT A LOCATOR SERVICE PRIOR TO ANY EXCAVATION.

WHITE COPY Environmental Health YELLOW COPY (Final) Owner / Applicant PINK COPY (Initial) Owner / Applicant