IREDELL COUNTY HEALTH DEPARTMENT - *ENVIRONMENTAL HEALTH* ☒ STATESVILLE OFFICE 704-878-5305 ☐ MOORESVILLE OFFICE 704-664-5281

IMPROVEMENT PERMIT / AUTHORIZATION TO CONSTRUCT (1) OPERATION PERMIT (2) EXISTING SYSTEM INSPECTION

PERMIT # 166489 PIN # 4757753377 DATE June 10, 2011

OWNER Dianne Snyder APPLICANT: Bryan George PHONE: Home/Cell # 7044370355 Business #

SITE ADDRESS 1404 Turnersburg Hwy Statesville OWNER / APPLICANT ADDRESS

SITE DIRECTIONS 2M on Right before Dunlap Gate Rd.

SUBDIVISION BLOCK / SECTION LOT # LOT AREA ~2 acres DESIGN FLOW 480gpd L.T.A.R. ~.3

Septic Tank 1000 Gallons: STB 1012 Date 9-14-10 ☐ New System ☒ Repair ☐ Expansion System Type I II (III) IV V VI

Pump Tank Gallons: P T Date System Description:

Pump Make Model Serial # Repair System Description: Gravity 25% Reduction

No. Nitrification Fields: 1 No. Lines 3 Linear Feet 400 Maintenance Agreement Required ☐ YES ☒ NO

Trench Width 36" Max. Trench Bottom Depth 36" Gravel Depth NA ☒ GRAVITY ☐ PRESSURE


☒ Residence No. Bedrooms 4 ☐ Business No. Persons ☐ Other No. Employees ☐ Slab ☒ Crawl Space ☐ Basement w/plumbing ☐ Basement w/o plumbing

Water Supply: ☐ Private ☒ Public ☐ Community


Comments / Conditions: Repair/replacement septic system to be installed before addition is completed.

Polylok Filter

INITIAL SITE SKETCH

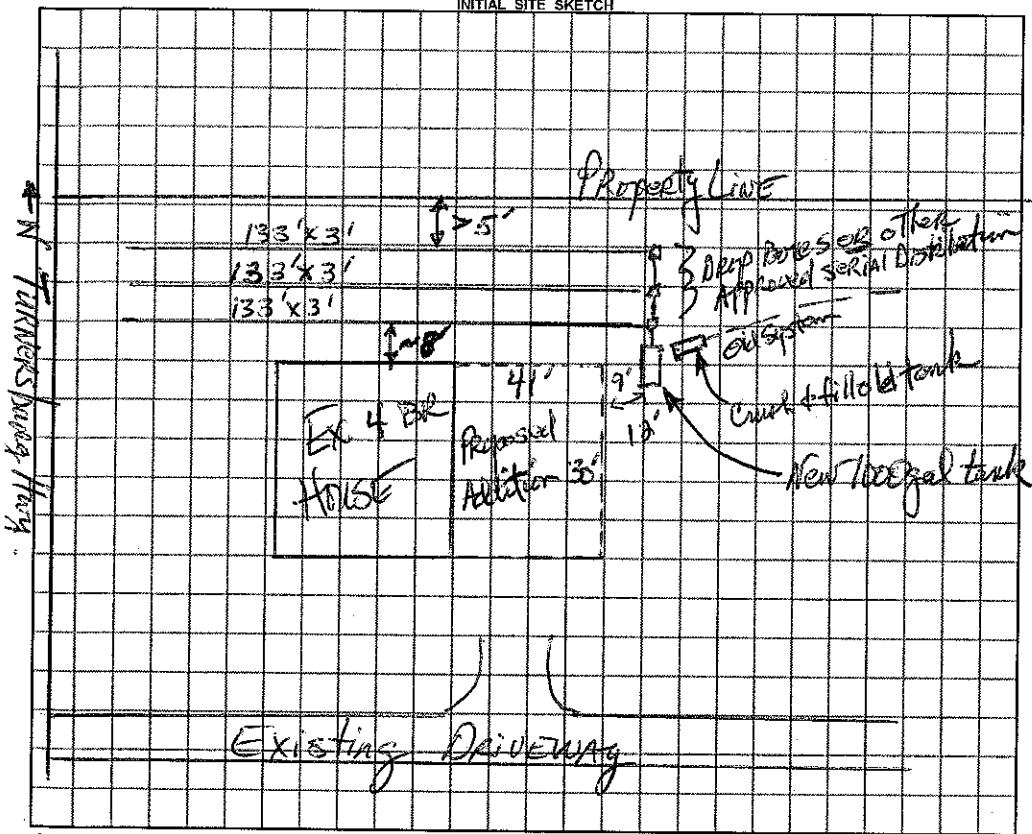

AS BUILT SKETCH

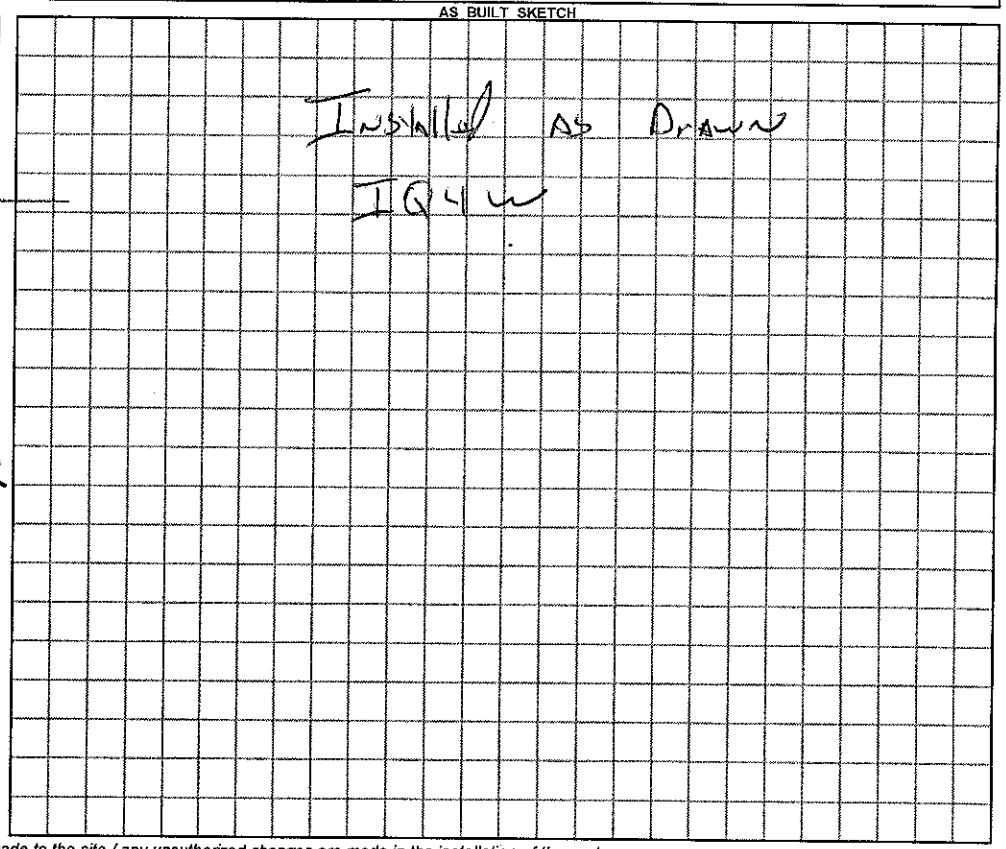

Permit can be suspended or revoked if any false information is supplied toward securing the permit / any unauthorized changes are made to the site / any unauthorized changes are made in the installation of the system.

☐ ***IMPROVEMENT PERMIT*** with plat valid without expiration. ☒ ***IMPROVEMENT PERMIT*** with plat valid without expiration. site plan valid 60 mo. ☒ ***AUTHORIZATION TO CONSTRUCT*** valid for period equal to IMPROVEMENT PERMIT--not to exceed 60 mo.

Owner / Applicant Signature: Bryan George Date 6/10/11 Installed by: Steve Jordan

IMPROVEMENT PERMIT by: REHS Date 6-10-11 OPERATION PERMIT by: REHS Date 9-12-11

AUTHORIZATION TO CONSTRUCT by: REHS Date 6-10-11 Existing System Inspected by: REHS Date

YOU SHOULD CONTACT A LOCATOR SERVICE PRIOR TO ANY EXCAVATION

White Copy -- Environmental Health YELLOW COPY (Final) Owner / Applicant PINK COPY (Initial) Owner / Applicant