IREDELL COUNTY HEALTH DEPARTMENT

STATESVILLE 704-878-5305 C MOORESVILLE 704-664-5281 (C1)

IMPROVEMENT PERMIT / AUTHORIZATION TO CONSTRUCT / OPERATION PERMIT / EXISTING SYSTEM INSPECTION

PERMIT# 129426 PIN# 4757-77-6602 DATE 6-24-05

OWNER OR CONTRACTOR WENDELL P. PHILLIPS PHONE: Business 704-880-7515 Home 704-876-0737

ADDRESS 148 WILLOW BRANCH LANE STATESVILLE, NC 28625-1409

LOCATION US 21 N, TL WILLOW BRANCH LANE, MH ON RIGHT AFTER 1ST CURVE.

SUBDIVISION _____ BLOCK / SECTION _____ LOT _____ LOT AREA 4.882 ACRES SITE CLASS. PS DESIGN FLOW 240 L.T.A.R. EXISTING

Septic Tank: 1000 Gallons; STB _____ Date _____

Pump Tank: _____ Gallons; PT _____ Date _____

Pump Make: _____ Model _____ Serial No. _____

Nitrification Field: No Fields 1 Square Feet _____ Linear Feet EXISTING

No Lines 1 BED Trench Width _____ Max Trench Bottom Depth _____ Gravel Depth _____

☐ New System ☐ Repair System Type: I (II) III, IV, V, VI

System Description: CONVENTIONAL, GRAVITY

Repair System Description: _____

Maintenance Agreement Required: ☐ Yes ☑ No

☐ House/Mod. Home No. Bedrooms 2

☑ Mobile Home No. Bathrooms _____

☐ Business No. Employees _____

☐ Other _____

☐ Slab ☑ Crawl Space ☐ Basement w/plumbing ☐ Basement wo/plumbing


Water Supply: ☐ Individual ☑ Public ☐ Community

Comments:/Conditions:

Comments:/Conditions: SYSTEM UNDERSIZED ACCORDING TO TODAYS STANDARDS.

INITIAL SITE SKETCH

AS BUILT SKETCH

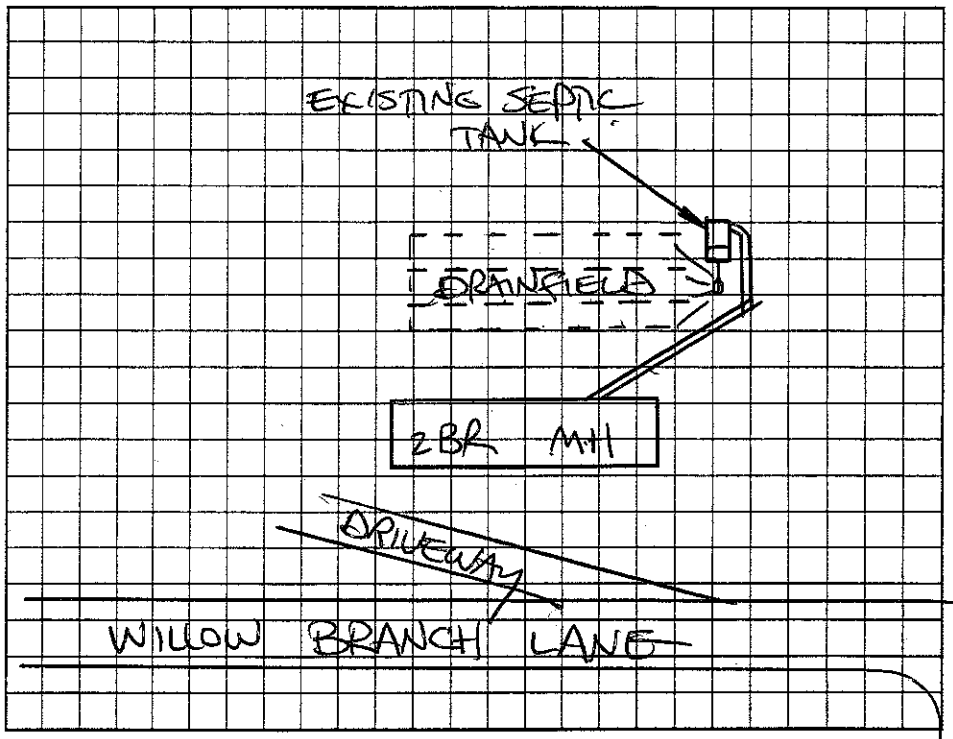

Permit can be suspended or revoked if any false information is supplied toward securing the permit/any unauthorized changes are made to the site/any unauthorized changes are made in the installation of the system. Improvement Permit with plat valid without expiration. Improvement Permit with site plan valid for sixty months. Authorization to Construct is valid for a period equal to that of Improvement Permit – not to exceed sixty months.

Signed: _____ date _____

Improvement Permit by: _____ date _____

Authorization to Construct by: _____ date _____

Installed by: _____

Operation Permit by: _____ date _____

Existing System Inspection by: STEVE HENDRICK date 6-24-05

HEALTH DEPT. COPY: WHITE OWNER COPY (FINAL): YELLOW OWNER COPY (INITIAL): PINK