IREDELL COUNTY HEALTH DEPARTMENT

Statesville Office (704) 878-5305 Mooresville Office (704) 660-3625 PERMIT # 176253

IMPROVEMENT PERMIT / AUTHORIZATION TO CONSTRUCT / OPERATION PERMIT / EXISTING SYSTEM

PIN # 4757865541

APPLICANT: James Dececco APPLICANT ADDRESS: 1464 Turnersburg Hwy

SITE ADDRESS: 1464 Turnersburg Hwy PHONE: 704-500-8507 ALT. PHONE: 704-500-7002

SITE DIRECTIONS: Hwy 21 N on ~~the~~ Right just passed Dunlap Gate Rd.

SUBDIVISION: Dunlap Gate SECTION: N/A LOT # 1 LOT AREA: 1.115 acres DESIGN FLOW: 360 gpd L.T.A.R.: 6X


Septic Tank	6X (gal)	STB	Date	☐ New System ☐ Repair ☐ Expansion System Type: I II ☒ III IV V VI	☑ Residence	No. Bedrooms	3	Water Supply	
Pump Tank	(gal)	PT	Date	System Description: 25% Reduction	☐ Business	No. Persons		☐ Private	
Pump Make	Model		Serial #	Repair System Description:	☐ Other	No. Employees		☑ Public	
# Nitrification Fields	1 # Lines	4	Linear Ft: 6X	Maintenance Agreement Required: ☐ YES ☒ NO	☐ Slab	☑ Crawl Space		☐ Community	
Trench Width	6X Max. Trench Bottom Depth	6X	Gravel Depth 6X	☑ GRAVITY ☐ PRESSURE	☐ Basement w/plumbing			☐ Basement w/o plumbing	

Comments / Conditions:

- Garage Addition must be a minimum of 5' from all components of septic tank system + repair areas.

INITIAL SITE SKETCH

AS BUILT SKETCH

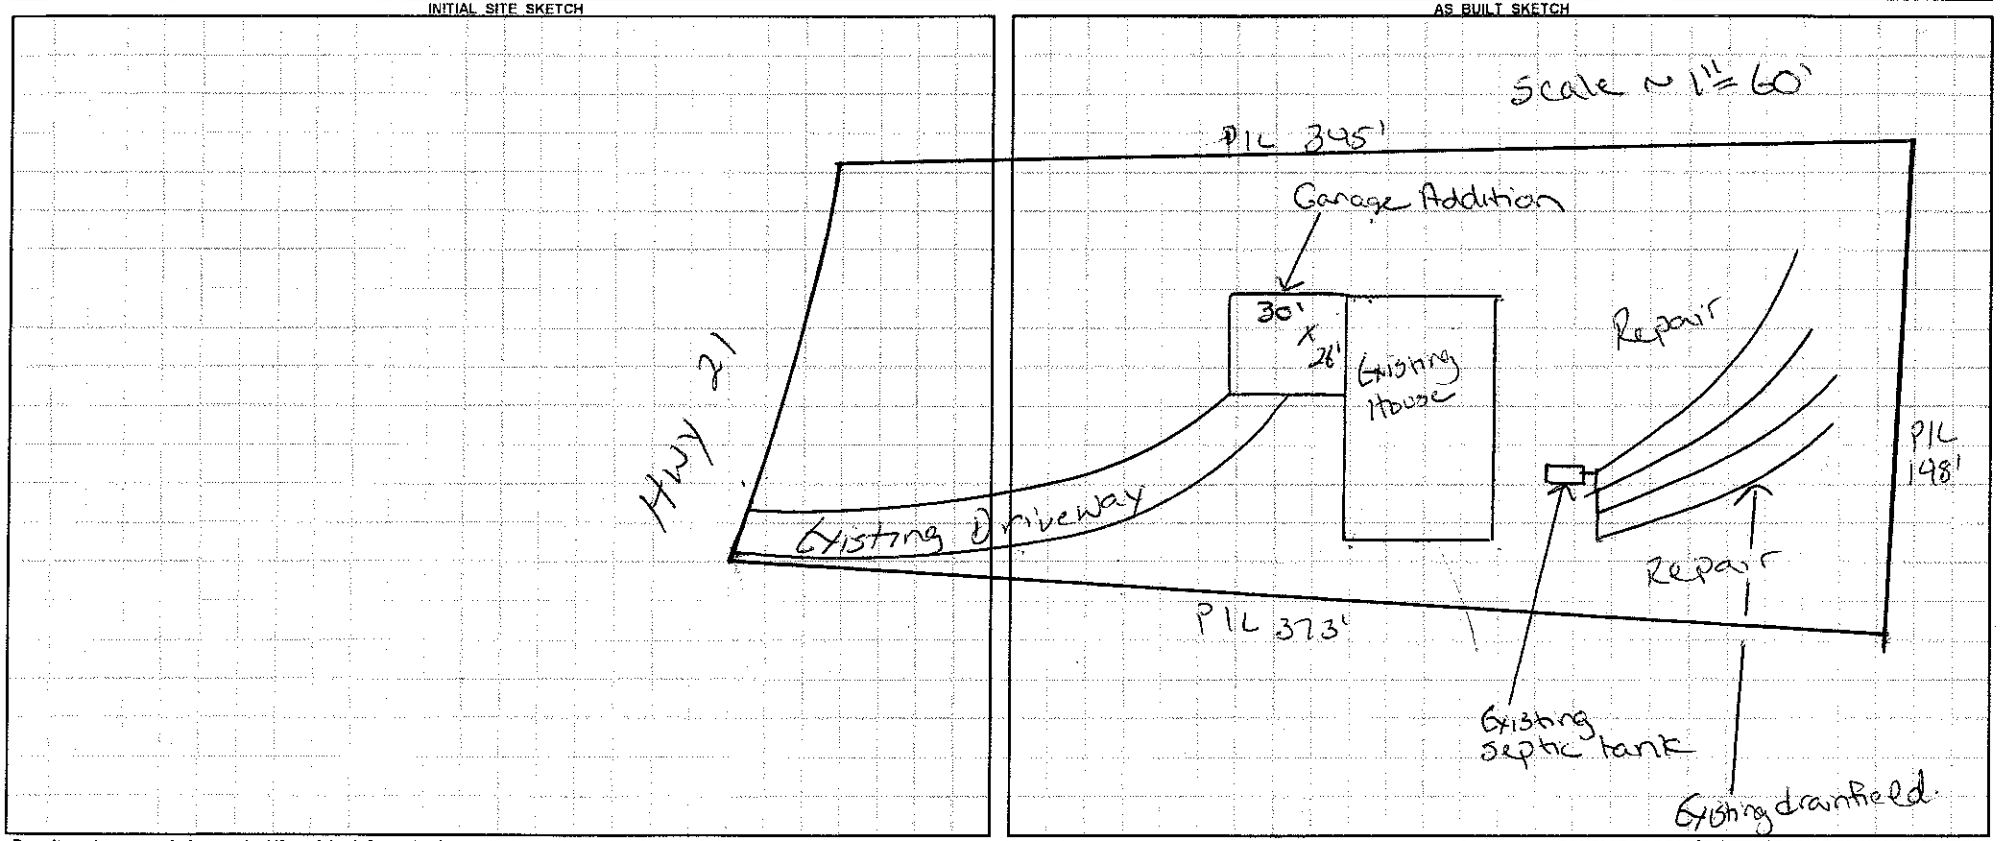

Permit can be suspended or revoked if any false information is supplied toward securing the permit / any unauthorized changes are made to the site / any unauthorized changes are made in the installation of the system. **CONTACT A LOCATOR SERVICE PRIOR TO ANY EXCAVATION**

☐ **IMPROVEMENT PERMIT** *with plat valid without expiration.* ☐ **IMPROVEMENT PERMIT** *with site plan valid for 60 mos.* ☐ **AUTHORIZATION TO CONSTRUCT** *valid for period equal to IMPROVEMENT PERMIT--not to exceed 60 mo.*

Owner / Applicant Signature: James DeCecco Date: 12-28-12 Installed by:

IMPROVEMENT PERMIT by: Date: OPERATION PERMIT by: Date:

AUTHORIZATION TO CONSTRUCT by: Date: Existing System Inspected by: Justin Mendenhall Date: 12-27-12

Health Dept. Copy - WHITE Applicant (Final Approval) - YELLOW Applicant (Conditional Approval) - PINK